


参考資料

大多喜町役場庁舎耐震補強増改築工事
竣工図

■建築意匠図

2012年 3月
千葉学建築計画事務所
CHIBA MANABU ARCHITECTS

建築面積

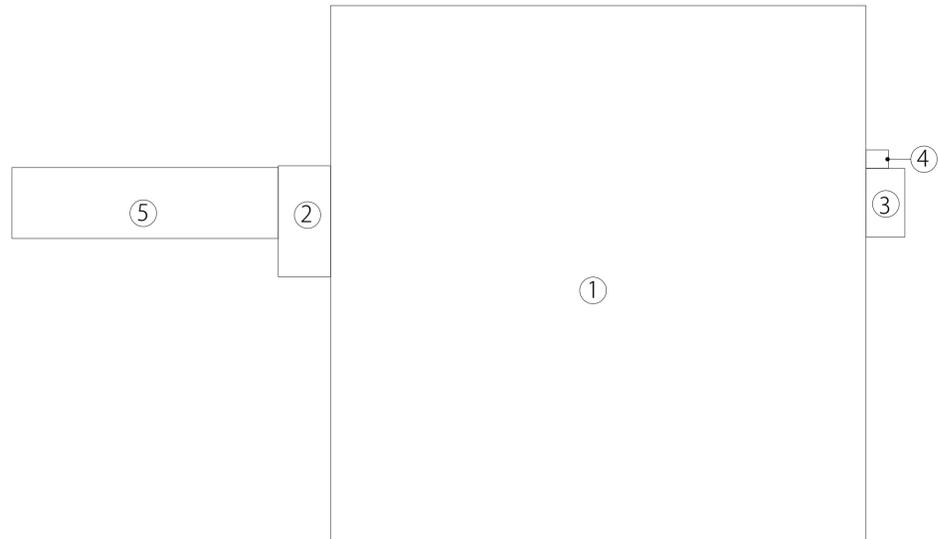


建築面積			
No.	底辺(m)	高さ(m)	面積(m ²)
1	30.340	30.340	920.515600
2	2.9625	6.290	18.634125
3	2.220	3.875	8.602500
4	1.295	1.0425	1.3500375
5	15.0975	4.000	60.390000
合計			1009.4922625

建築面積 1009.49m²

床面積


1階床面積

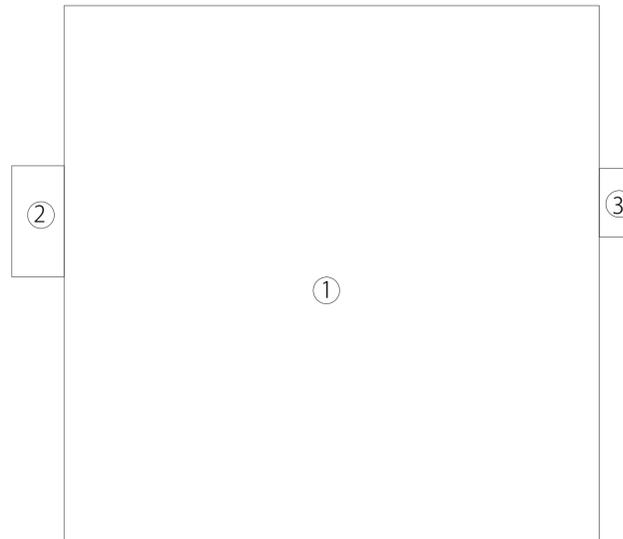

1階床面積			
No.	底辺(m)	高さ(m)	面積(m ²)
1	30.340	30.340	920.515600
2	2.9625	6.290	18.634125
3	2.220	3.875	8.602500
合計			947.752225

1階床面積 947.75m²

2階床面積

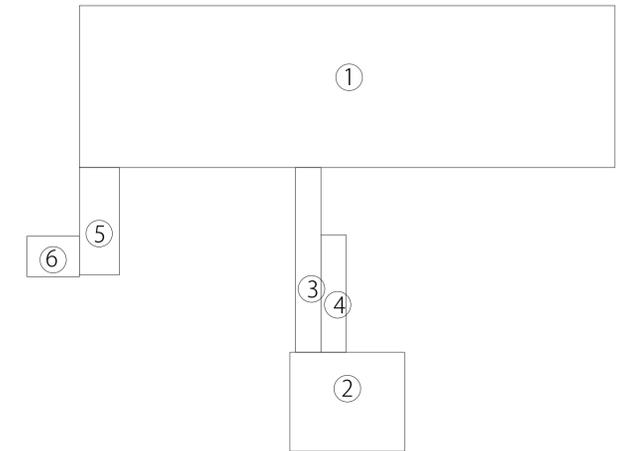

2階床面積			
No.	底辺(m)	高さ(m)	面積(m ²)
1	30.340	9.170	278.2178
2	6.500	5.600	36.400000
3	1.430	10.450	14.943500
4	1.430	6.645	9.502350
5	2.270	6.050	13.733500
6	2.9625	2.315	6.8581875
合計			359.6553375

2階床面積 359.65m²

地下1階床面積




地下1階床面積			
No.	底辺(m)	高さ(m)	面積(m ²)
1	3.000	6.050	18.150000
合計			18.150000

地下1階床面積 18.15m²

延べ面積

延べ面積	
	面積(m ²)
地下1階床面積	18.15
1階床面積	947.75
2階床面積	359.65
延べ面積	1325.55m ²


建築面積

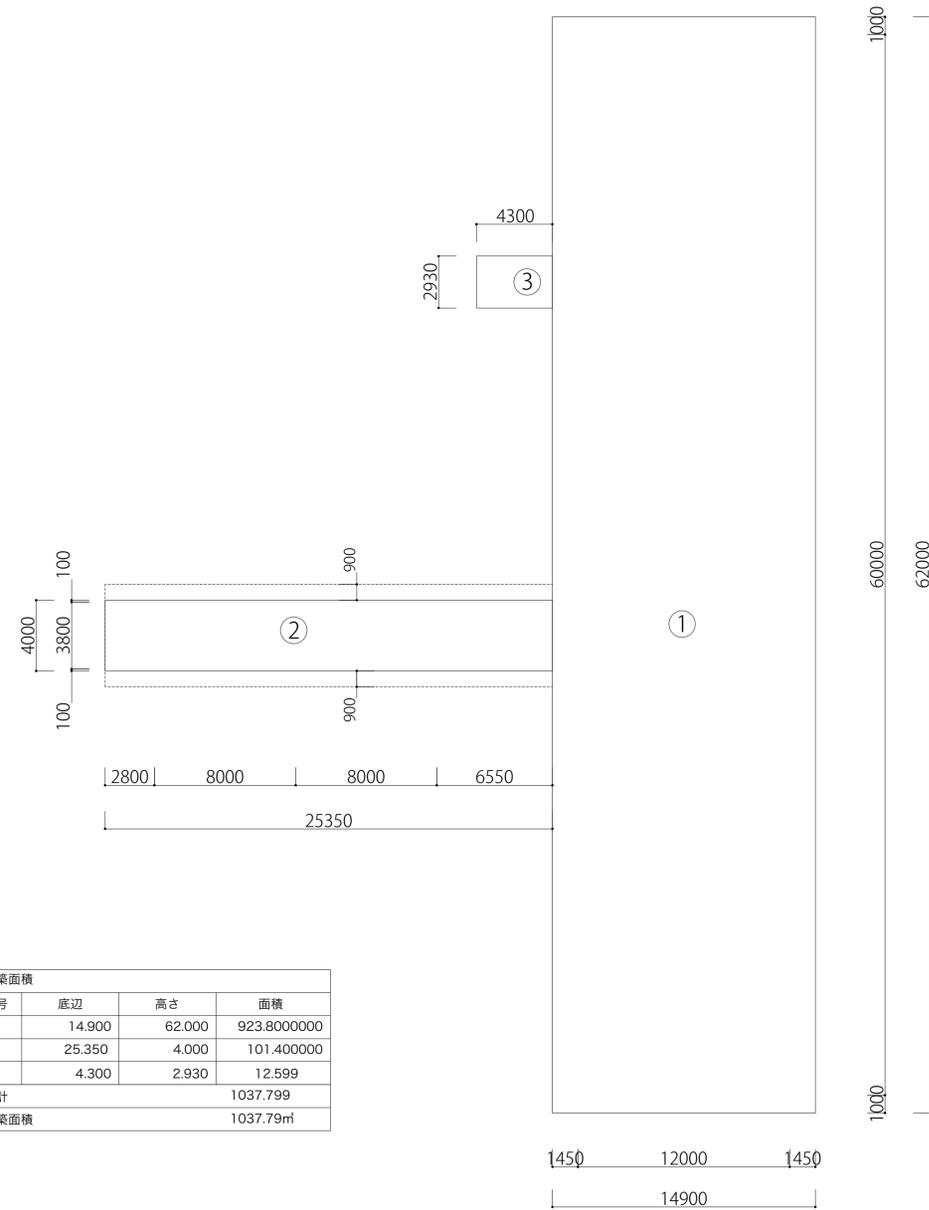

建築面積			
番号	底辺	高さ	面積
1	14.900	62.000	923.8000000
2	25.350	4.000	101.4000000
3	4.300	2.930	12.599
合計			1037.799
建築面積			1037.79㎡


床面積

1階床面積

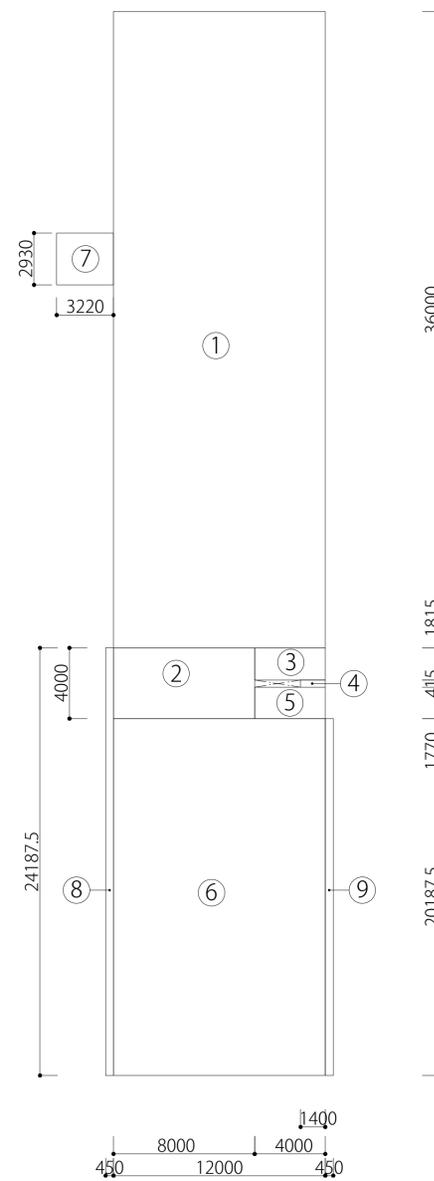


1階床面積				
番号	底辺	高さ	倍面積	面積
1	12.000	36.000	-	432.0000000
2	8.000	4.000	-	32.0000000
3	4.000	1.815	-	7.2600000
4	1.400	0.415	-	0.5810000
5	4.000	1.770	-	7.0800000
6	12.000	20.187	-	242.2440000
7	3.220	2.930	-	9.4346
8	0.450	24.187	-	10.8841500
9	0.450	20.187	-	9.0841500
合計				750.5679
床面積				750.56㎡

地下1階床面積

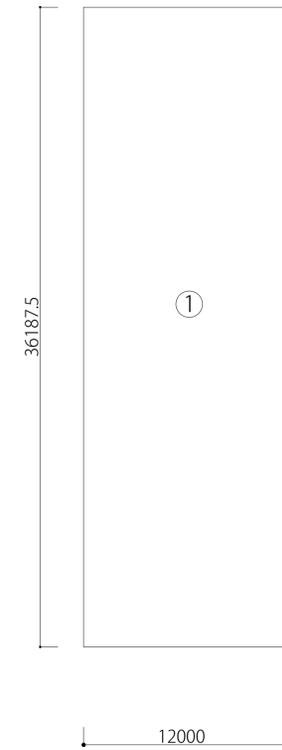

地下1階床面積				
番号	底辺	高さ	倍面積	面積
1	12.000	36.1875	-	434.25
床面積				434.25㎡

2階床面積

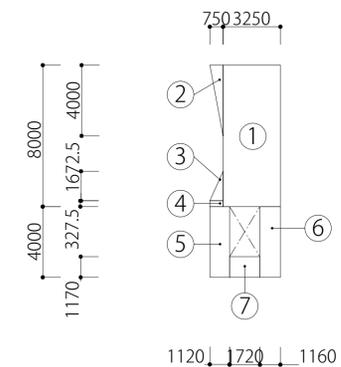


2階床面積				
番号	底辺	高さ	倍面積	面積
1	3.250	8.000	-	26.0000000
2	0.750	4.000	3.0000000	1.5000000
3	0.750	1.672	1.2540000	0.6270000
4	0.750	0.327	-	0.2452500
5	1.120	4.000	-	4.4800000
6	1.160	4.000	-	4.6400000
7	1.720	1.170	-	2.0124000
合計				39.5046500
床面積				39.50㎡

既存棟床面積表


建築面積	1037.79㎡
延べ面積	1224.31㎡
地下1階床面積	434.25㎡
1階床面積	750.56㎡
2階床面積	39.50㎡

県道大多喜停車場線




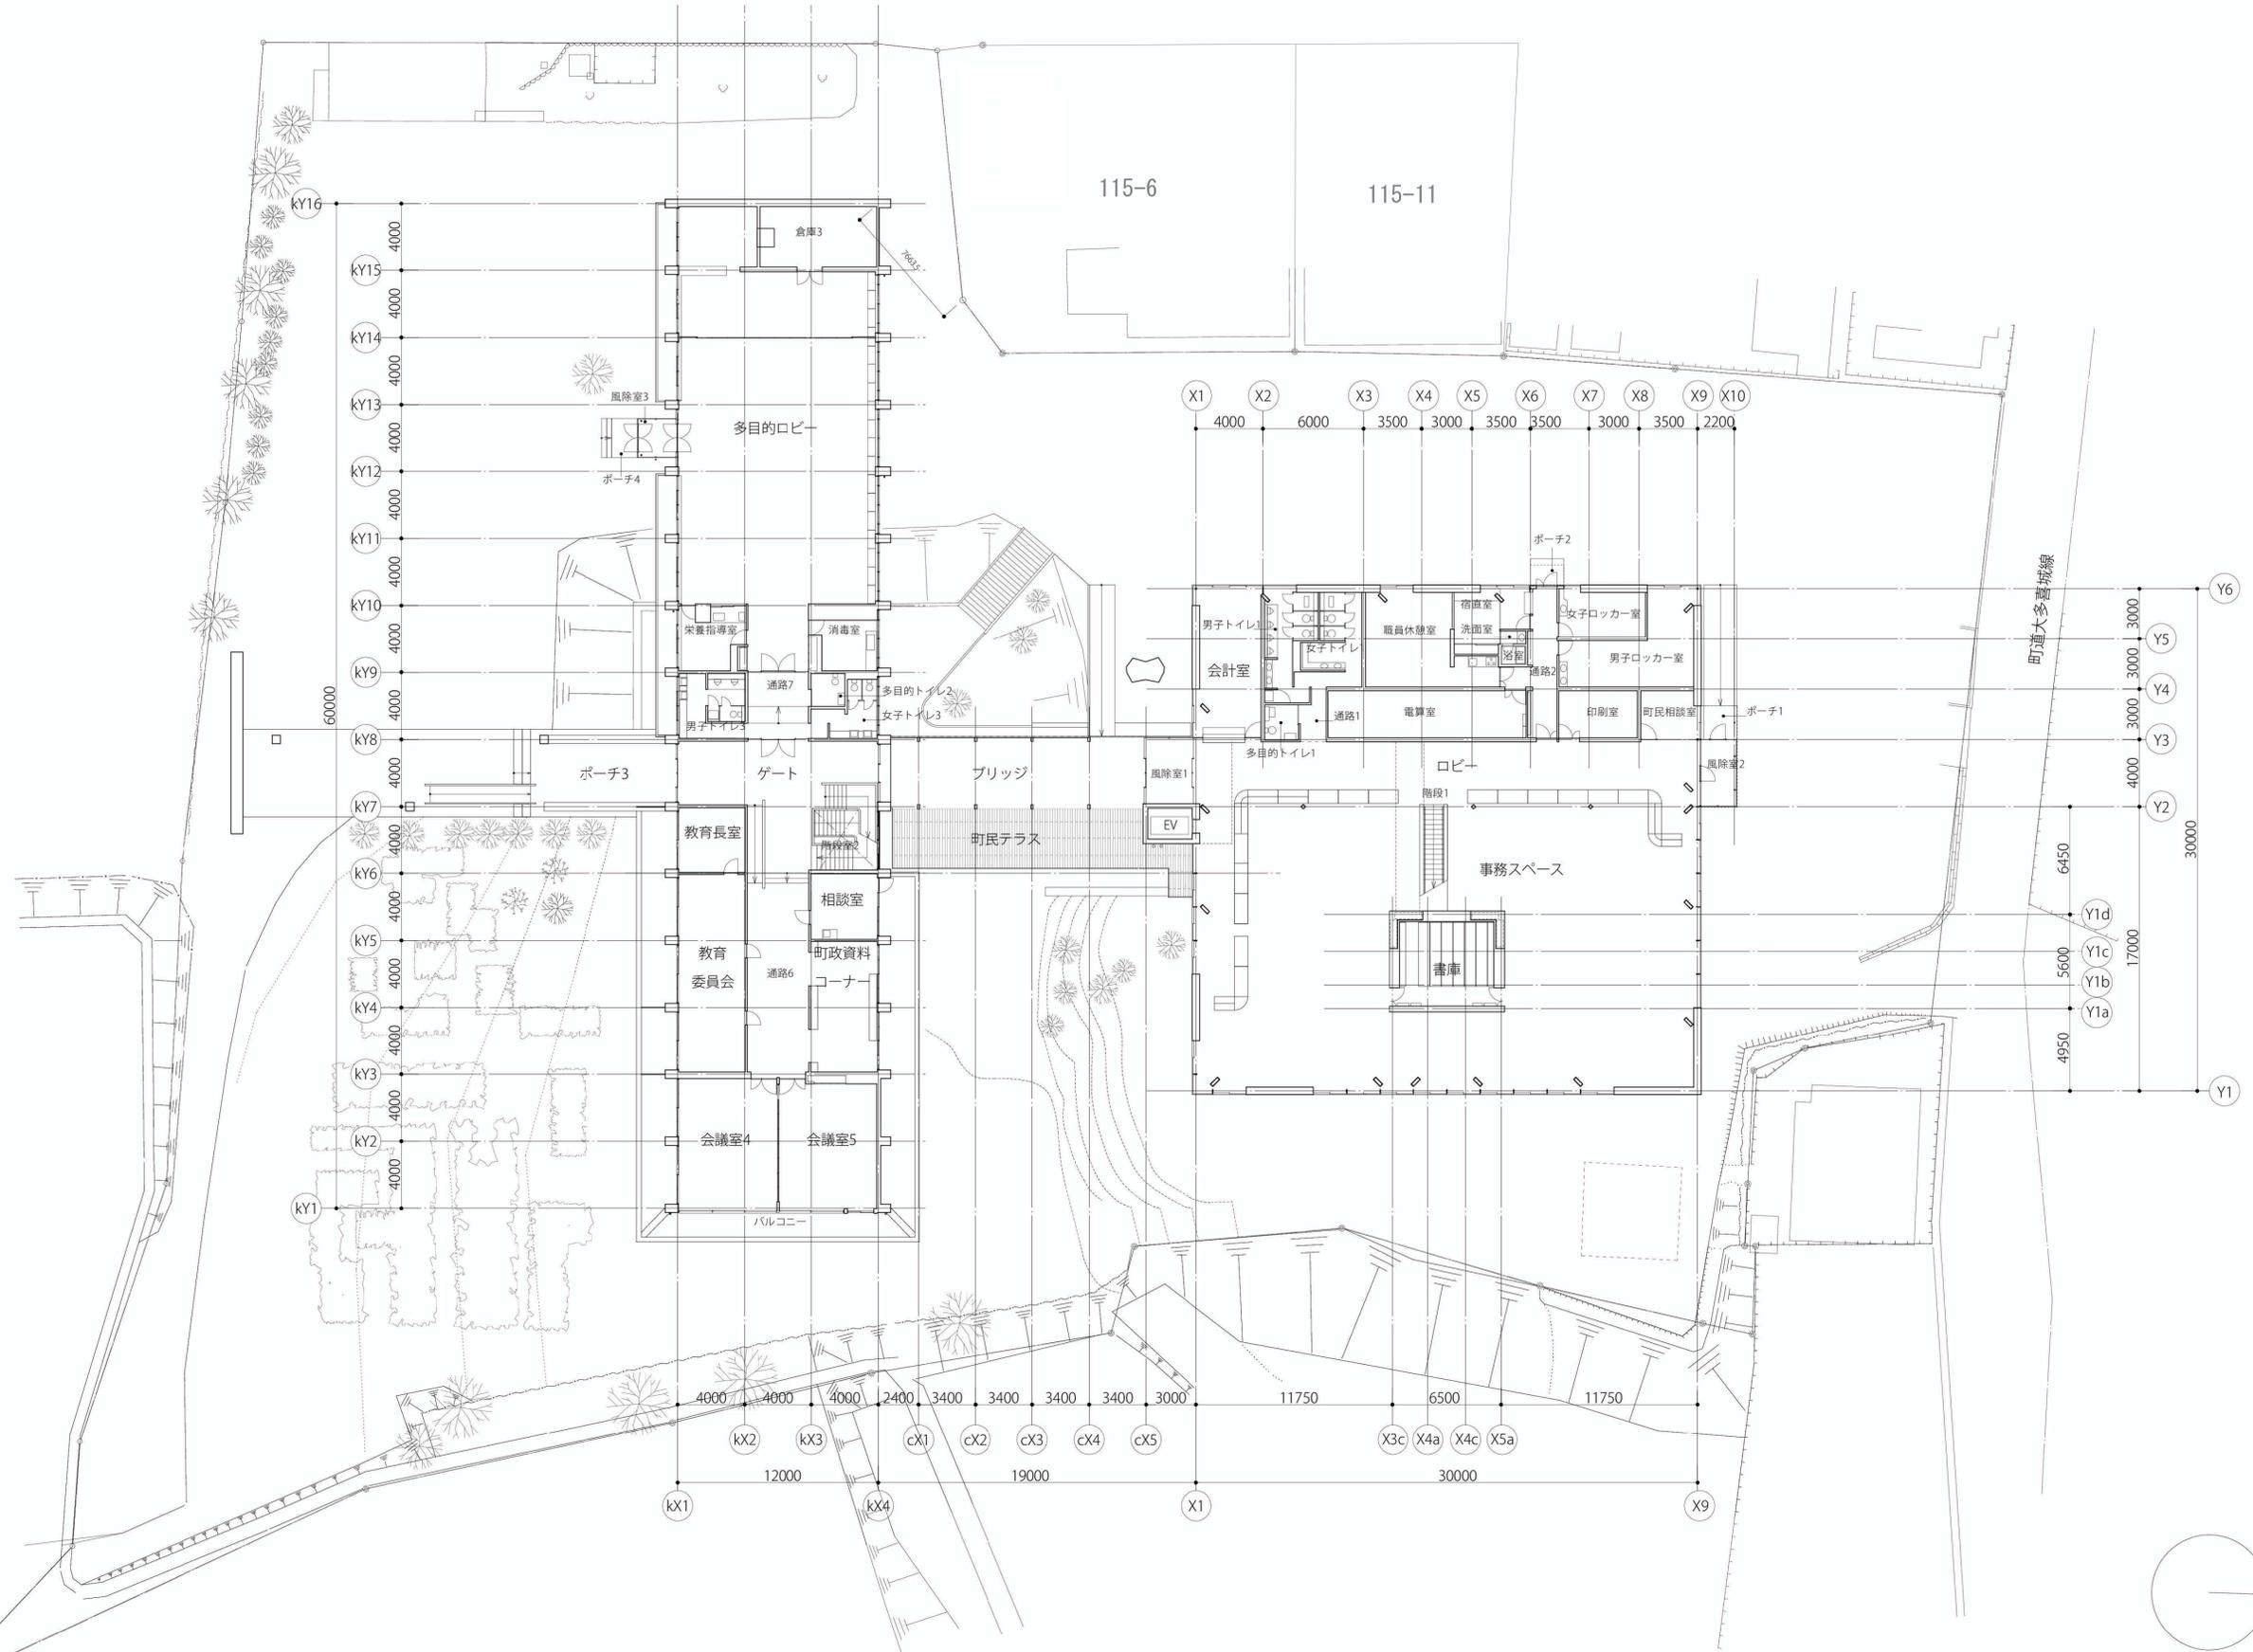


県道大多喜停車場線

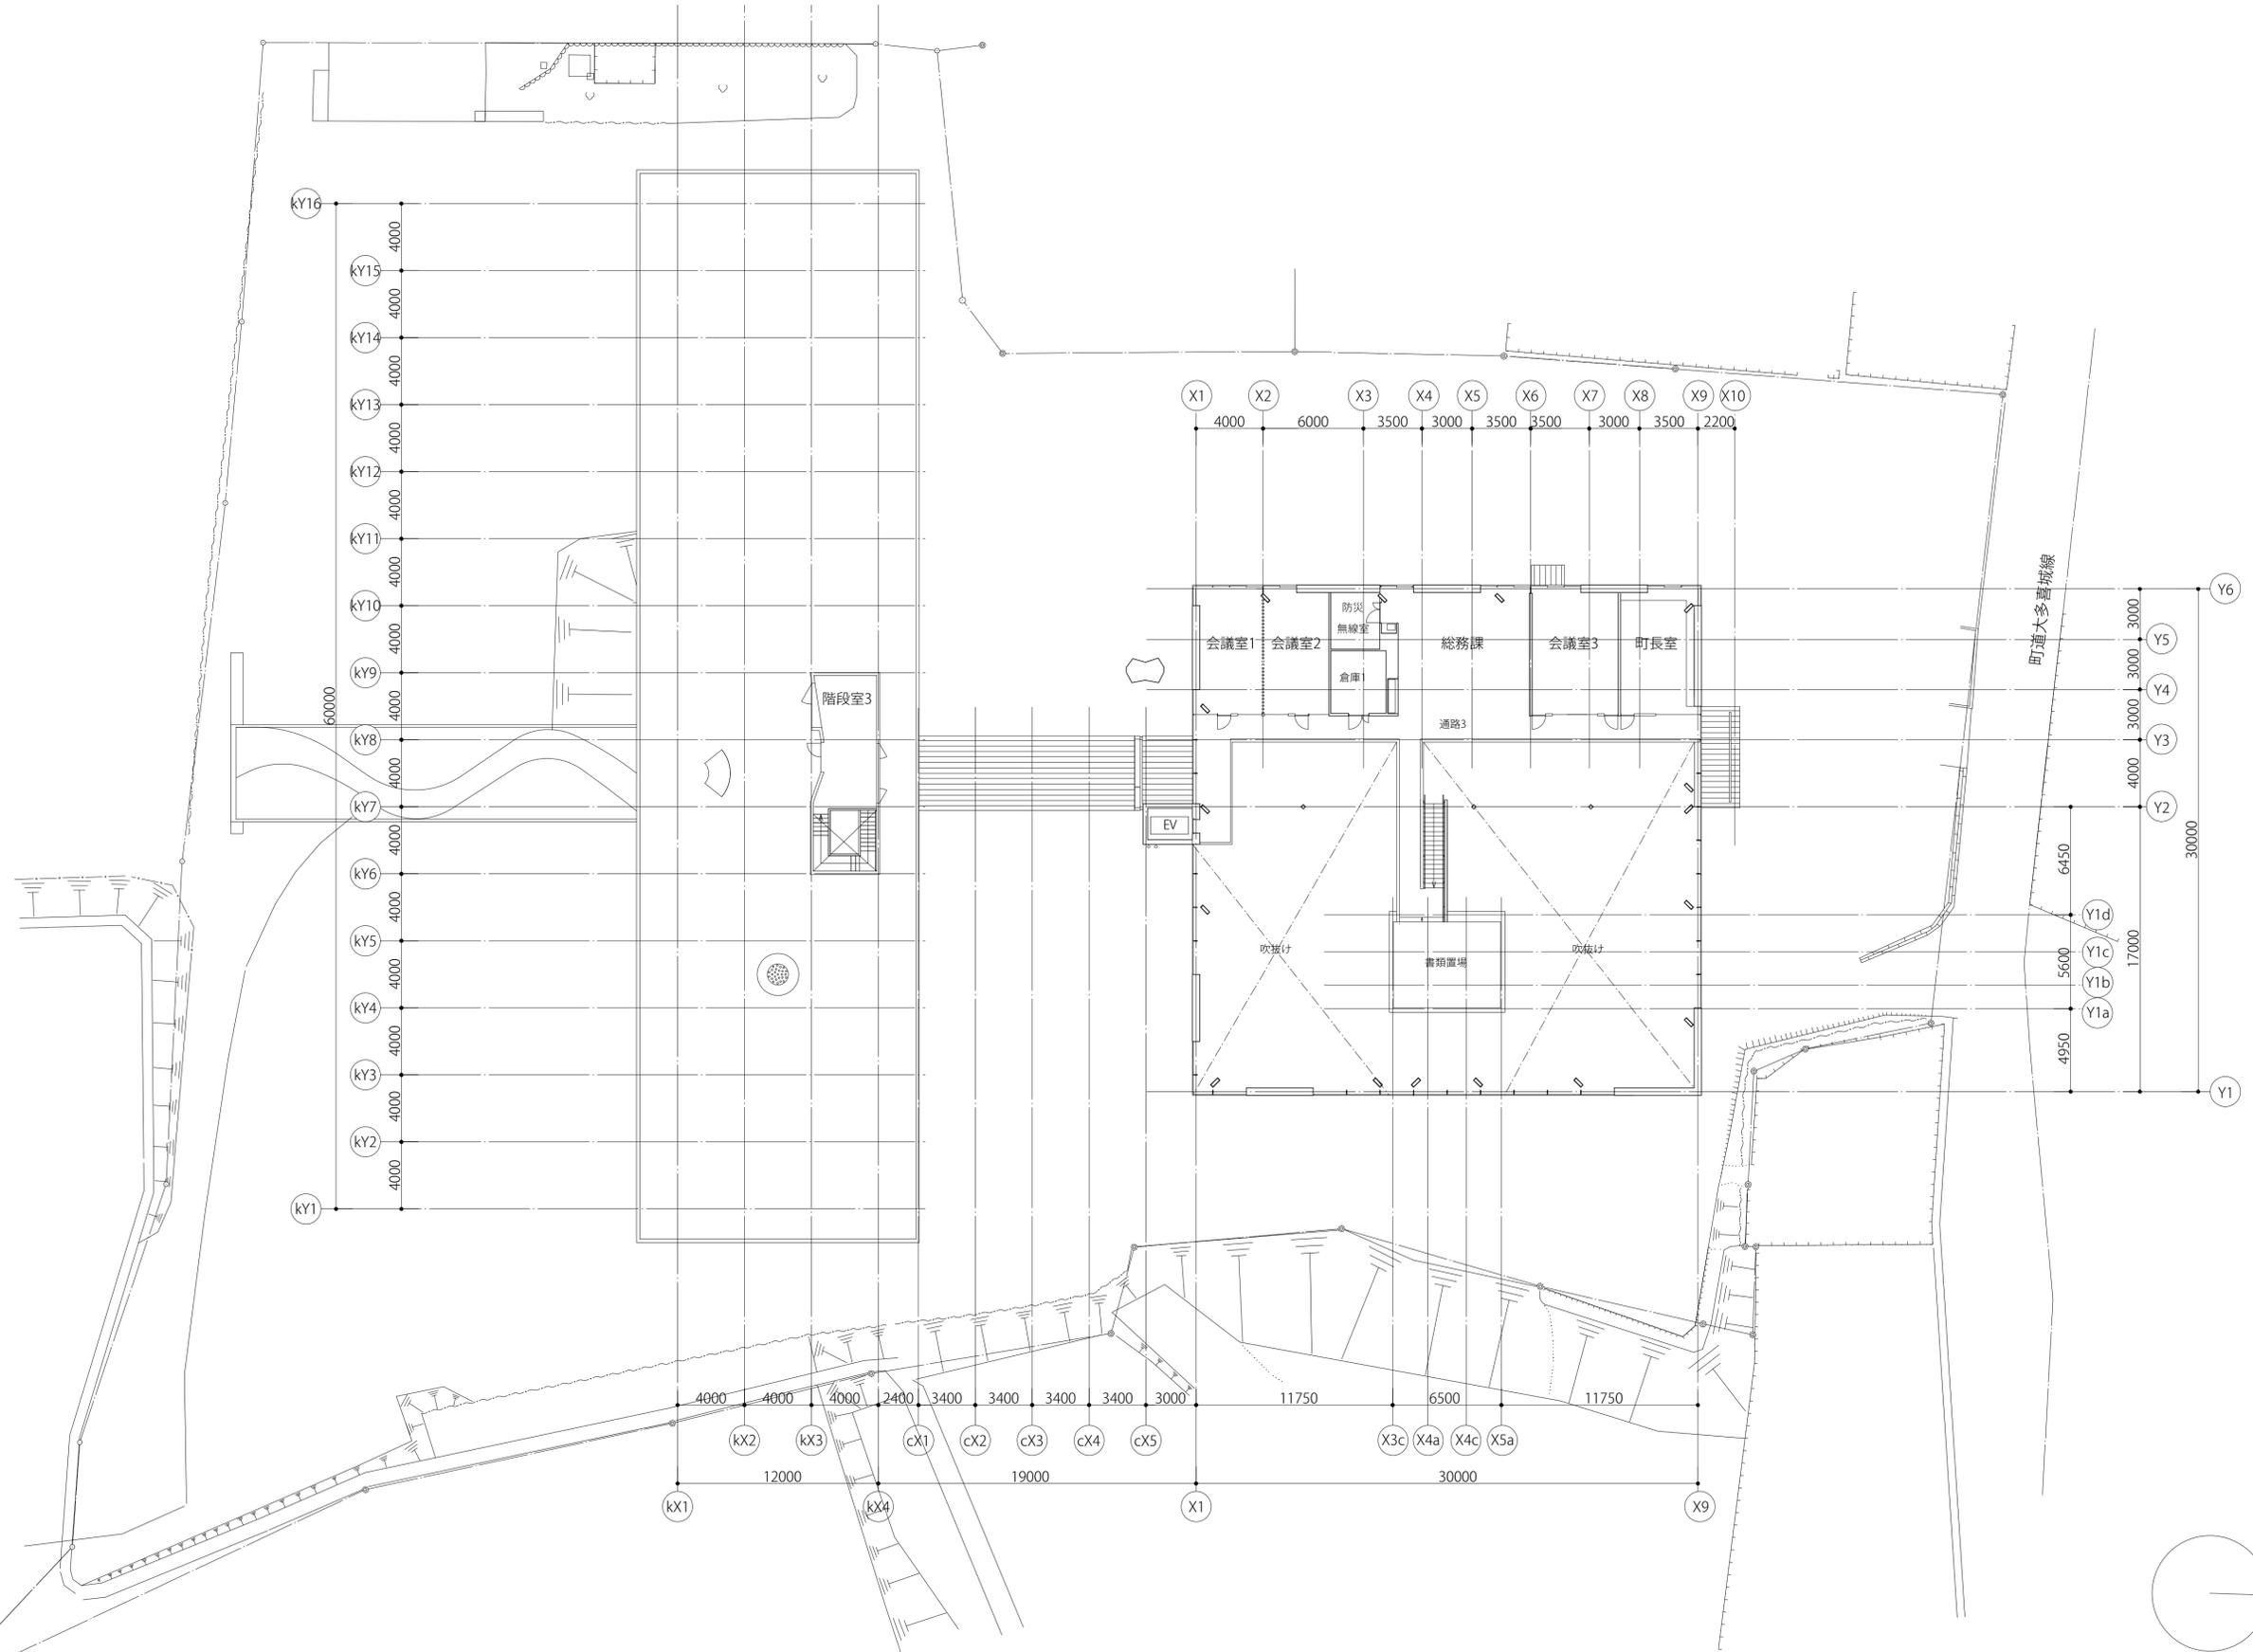


敷地境界線

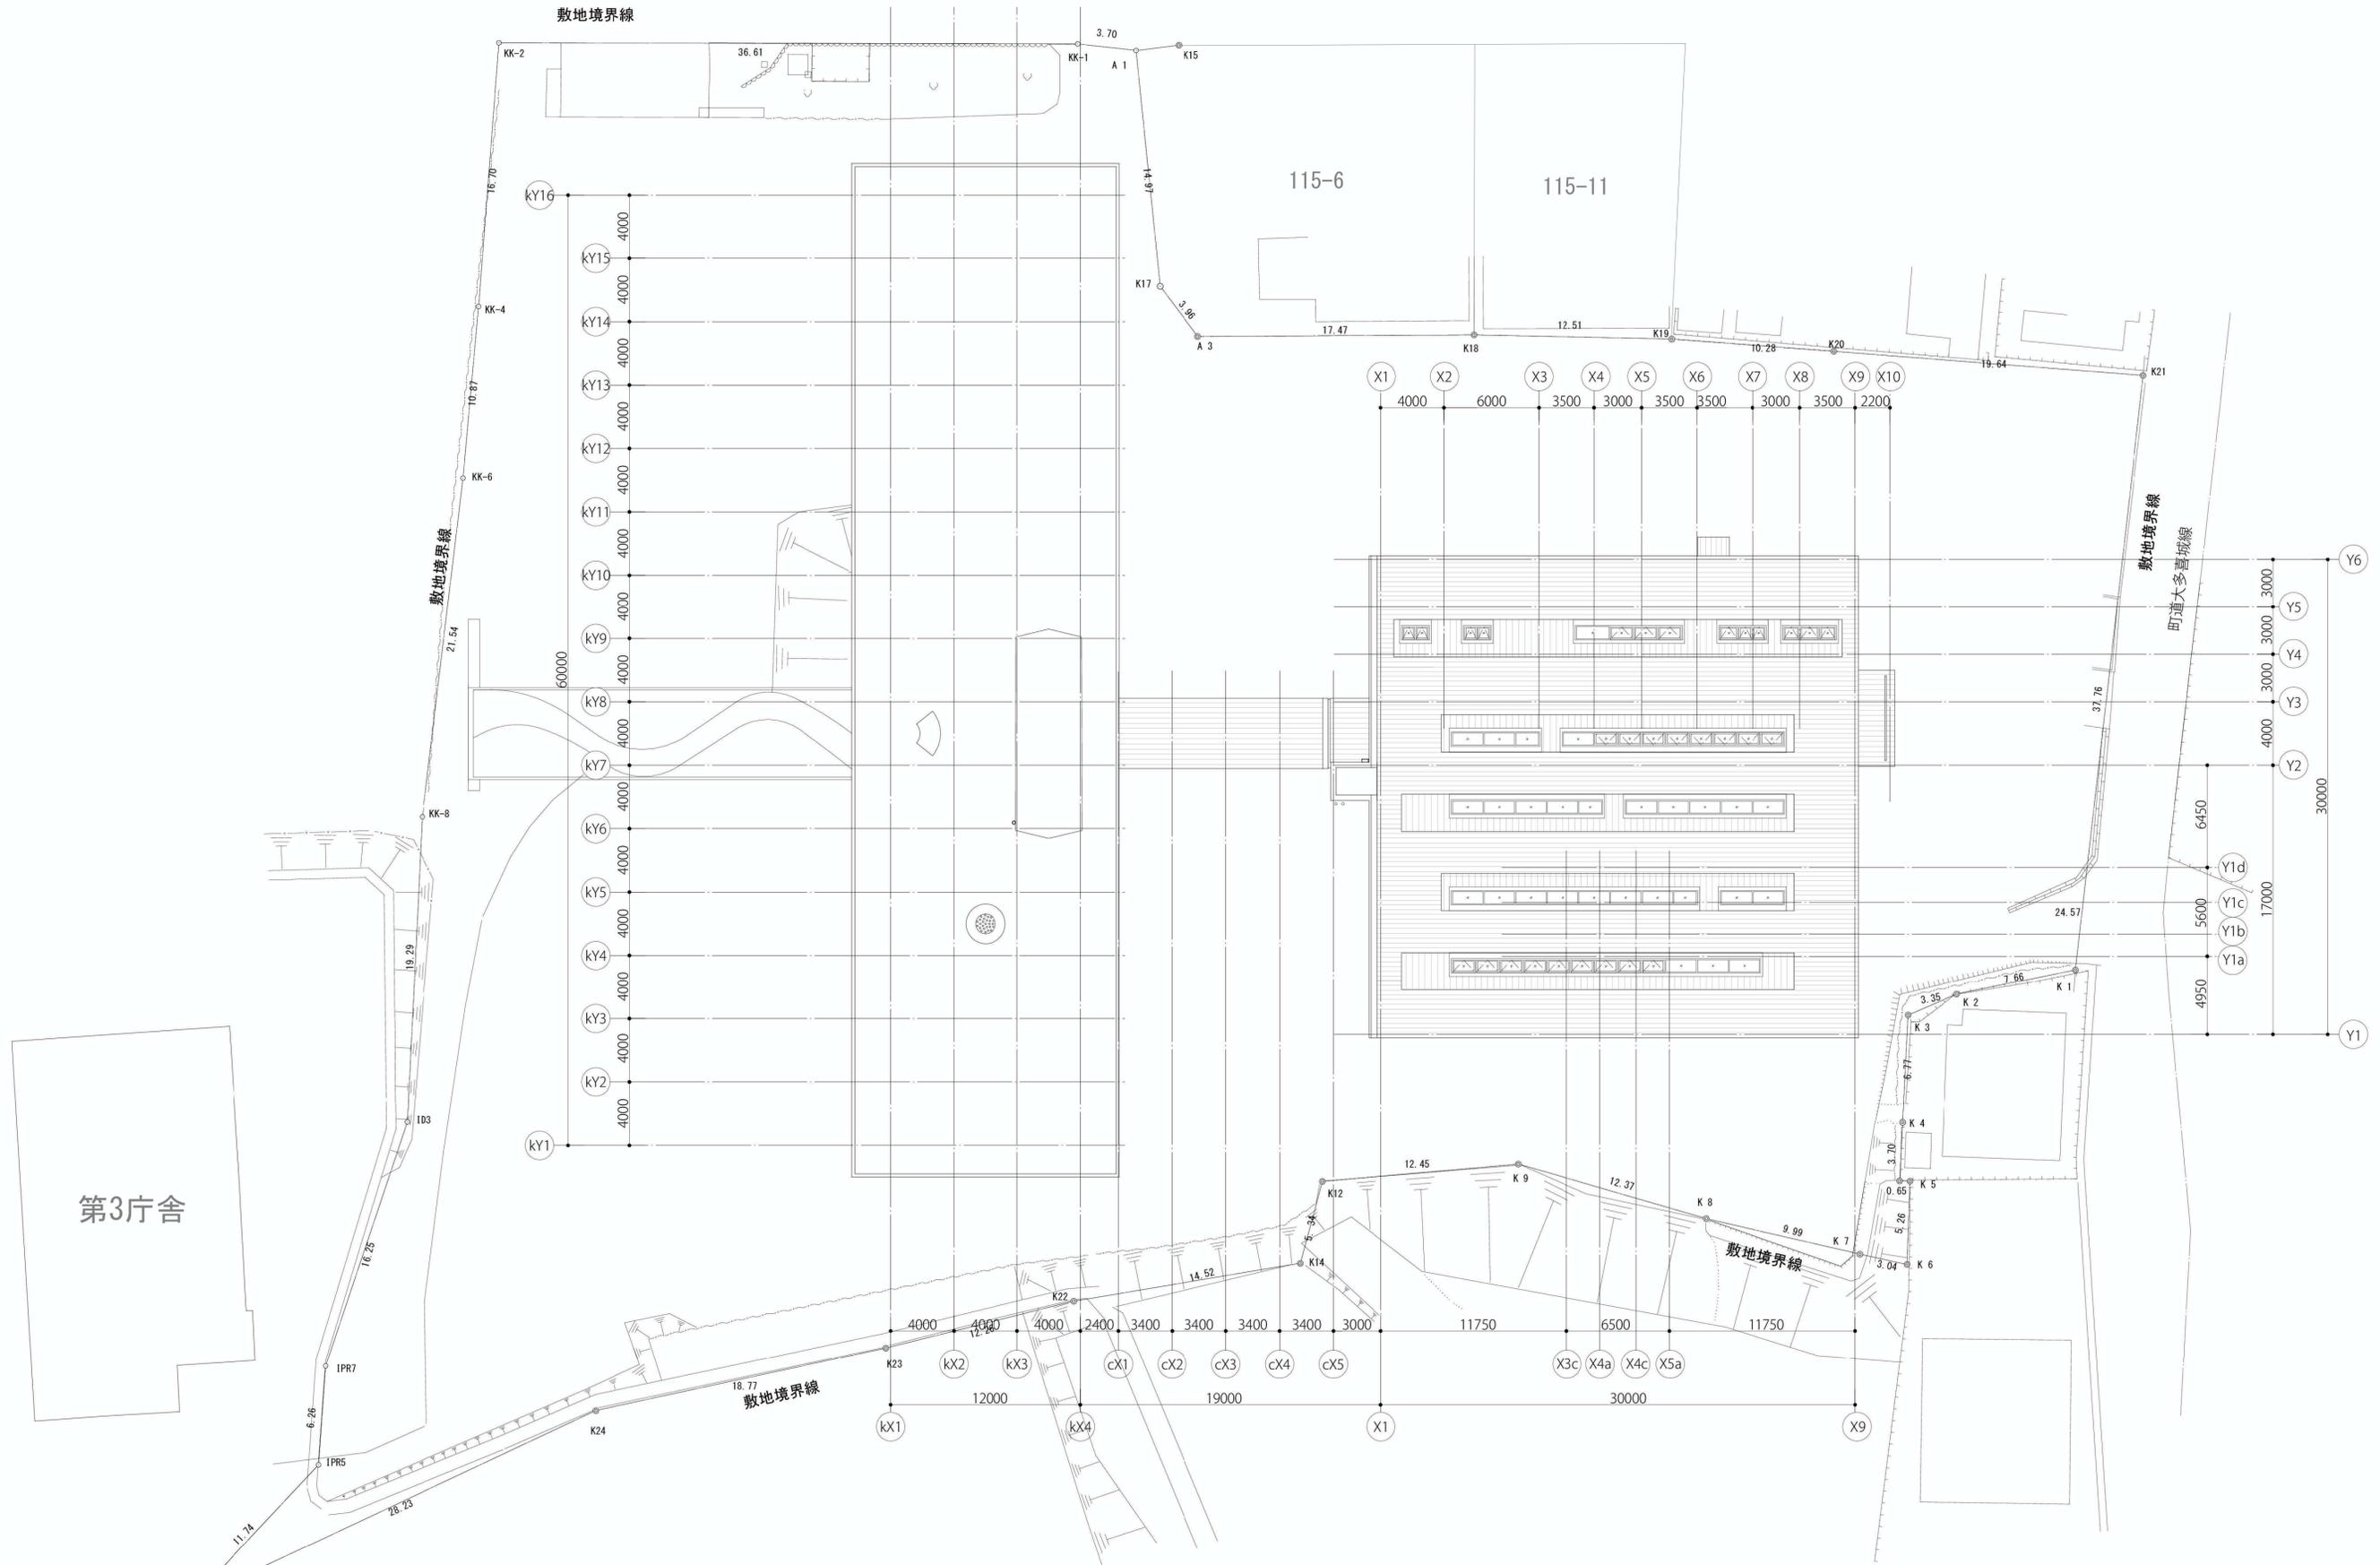

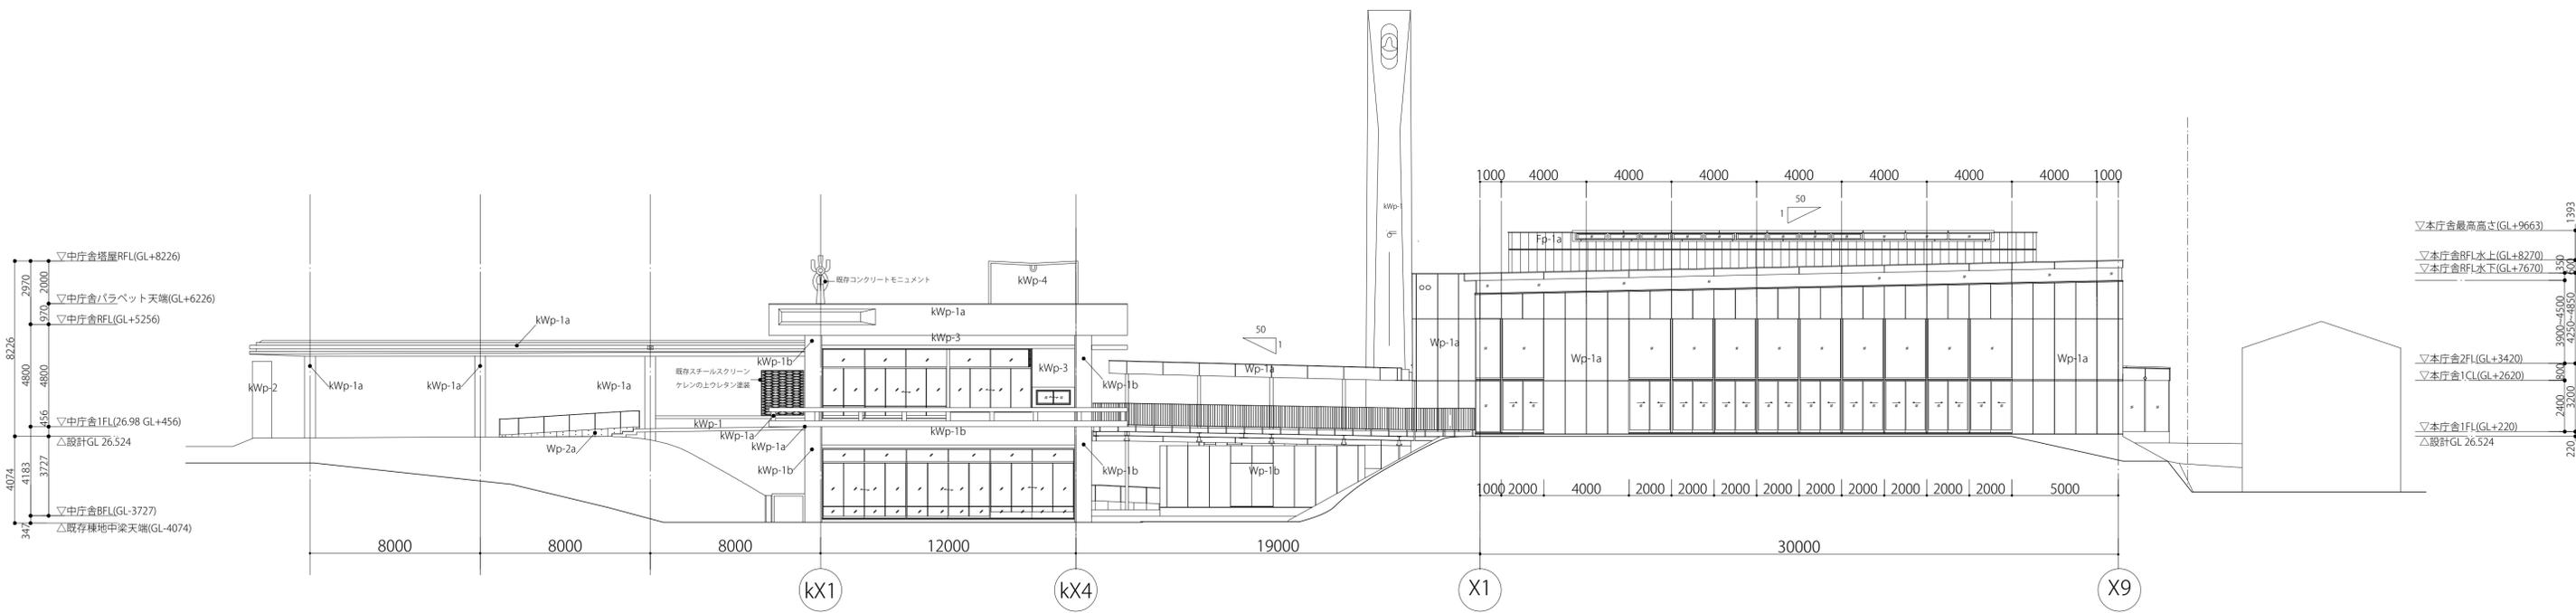


東立面図

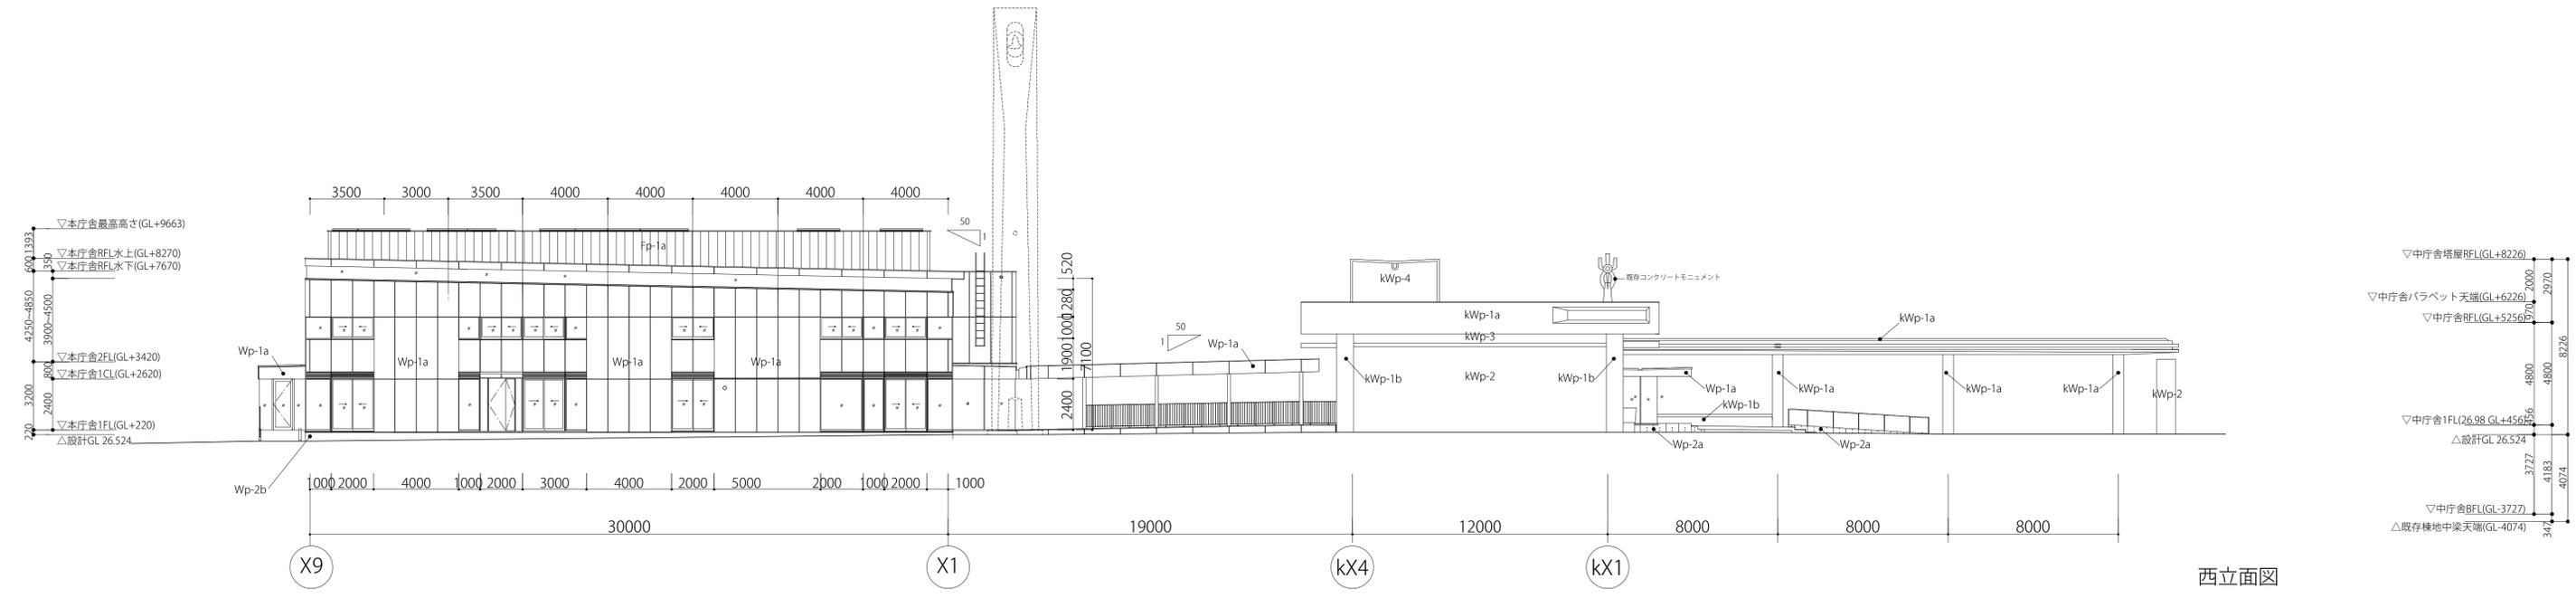


西立面図

▽本庁舎最高高さ(GL+9663)
 600.1393
 350
 4250~4850
 3900~4500
 800
 3200
 2400
 220
 △設計GL 26.524


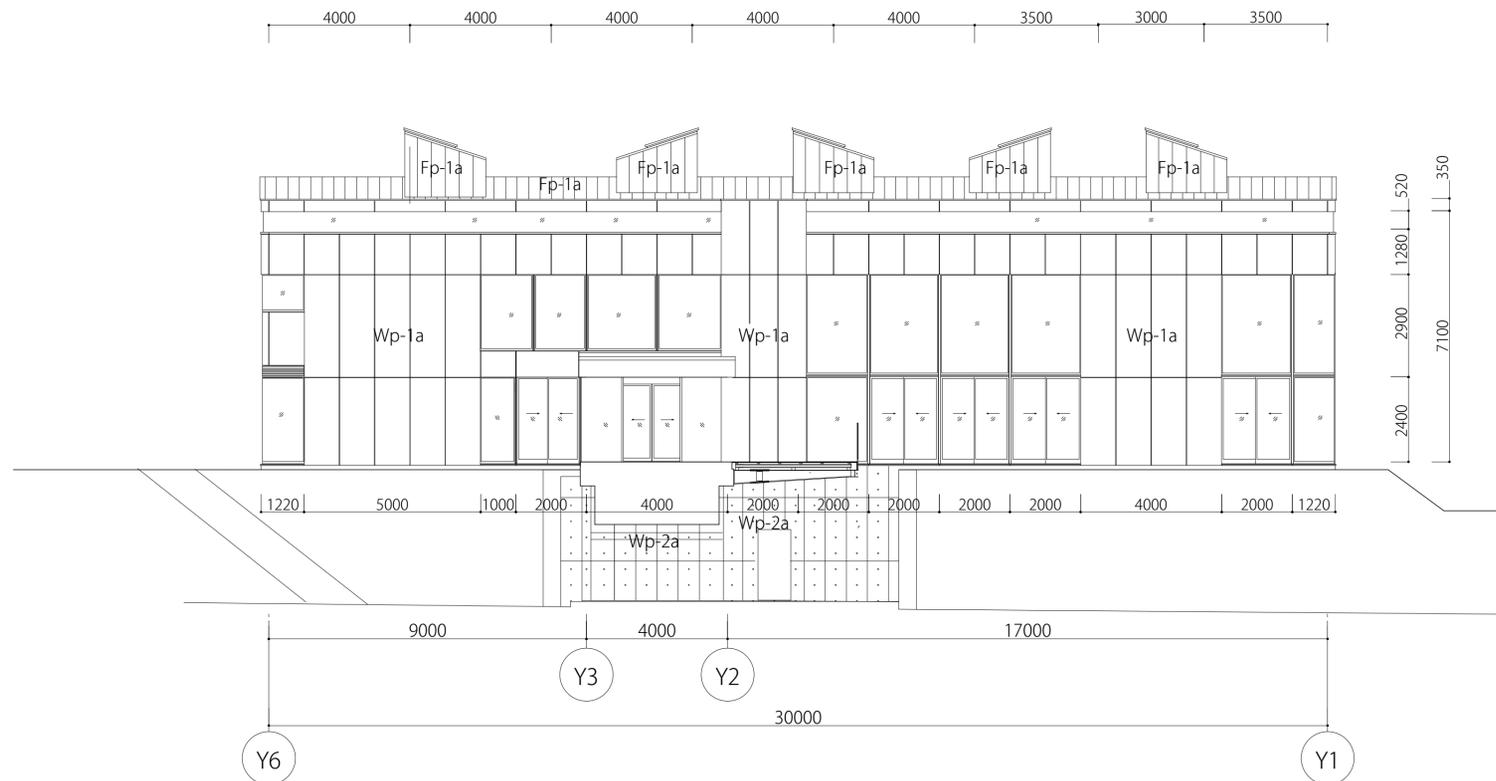






南立面図


▽本庁舎最高高さ(GL+9663)
 600.1393
 350
 4250~4850
 3900~4500
 800
 3200
 2400
 220
 △設計GL 26.524

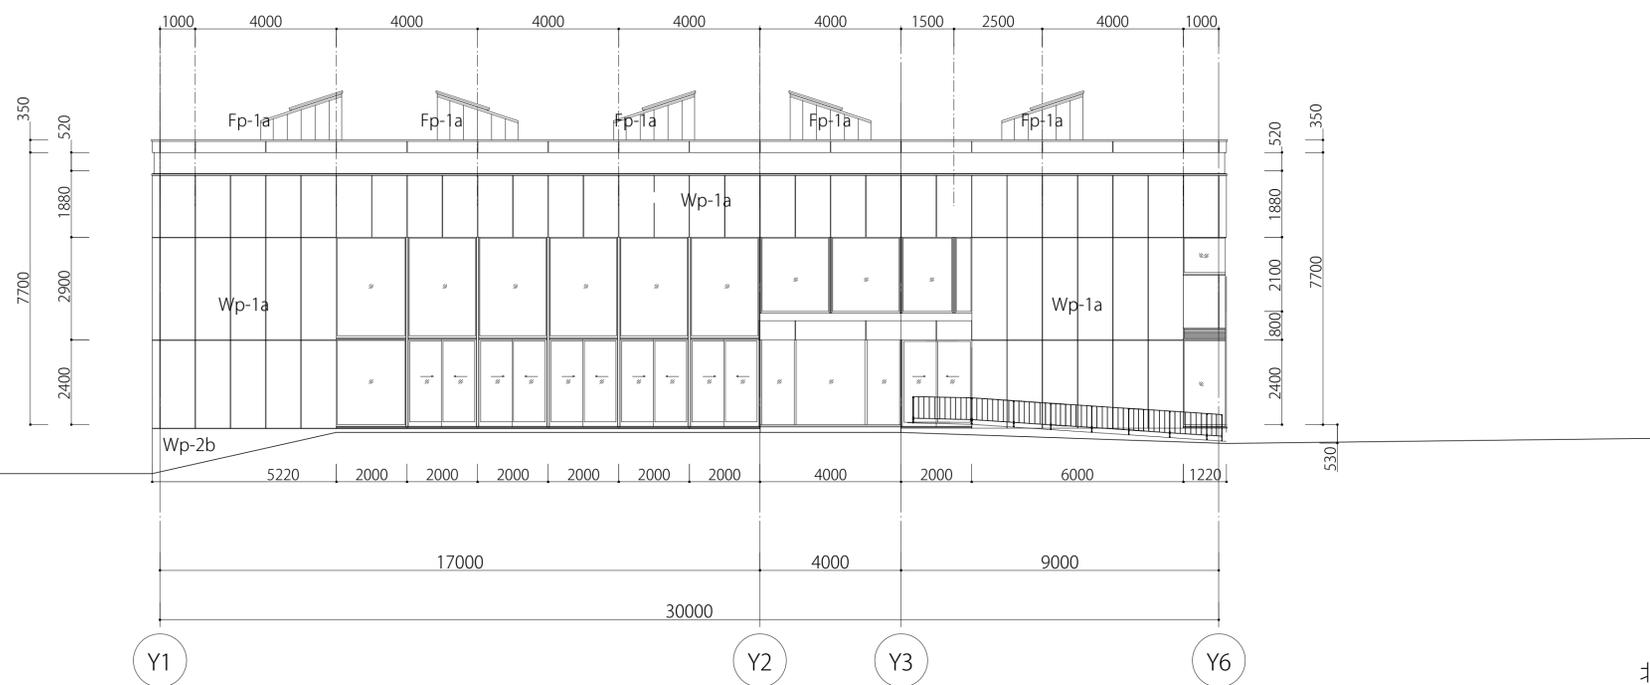



北立面図

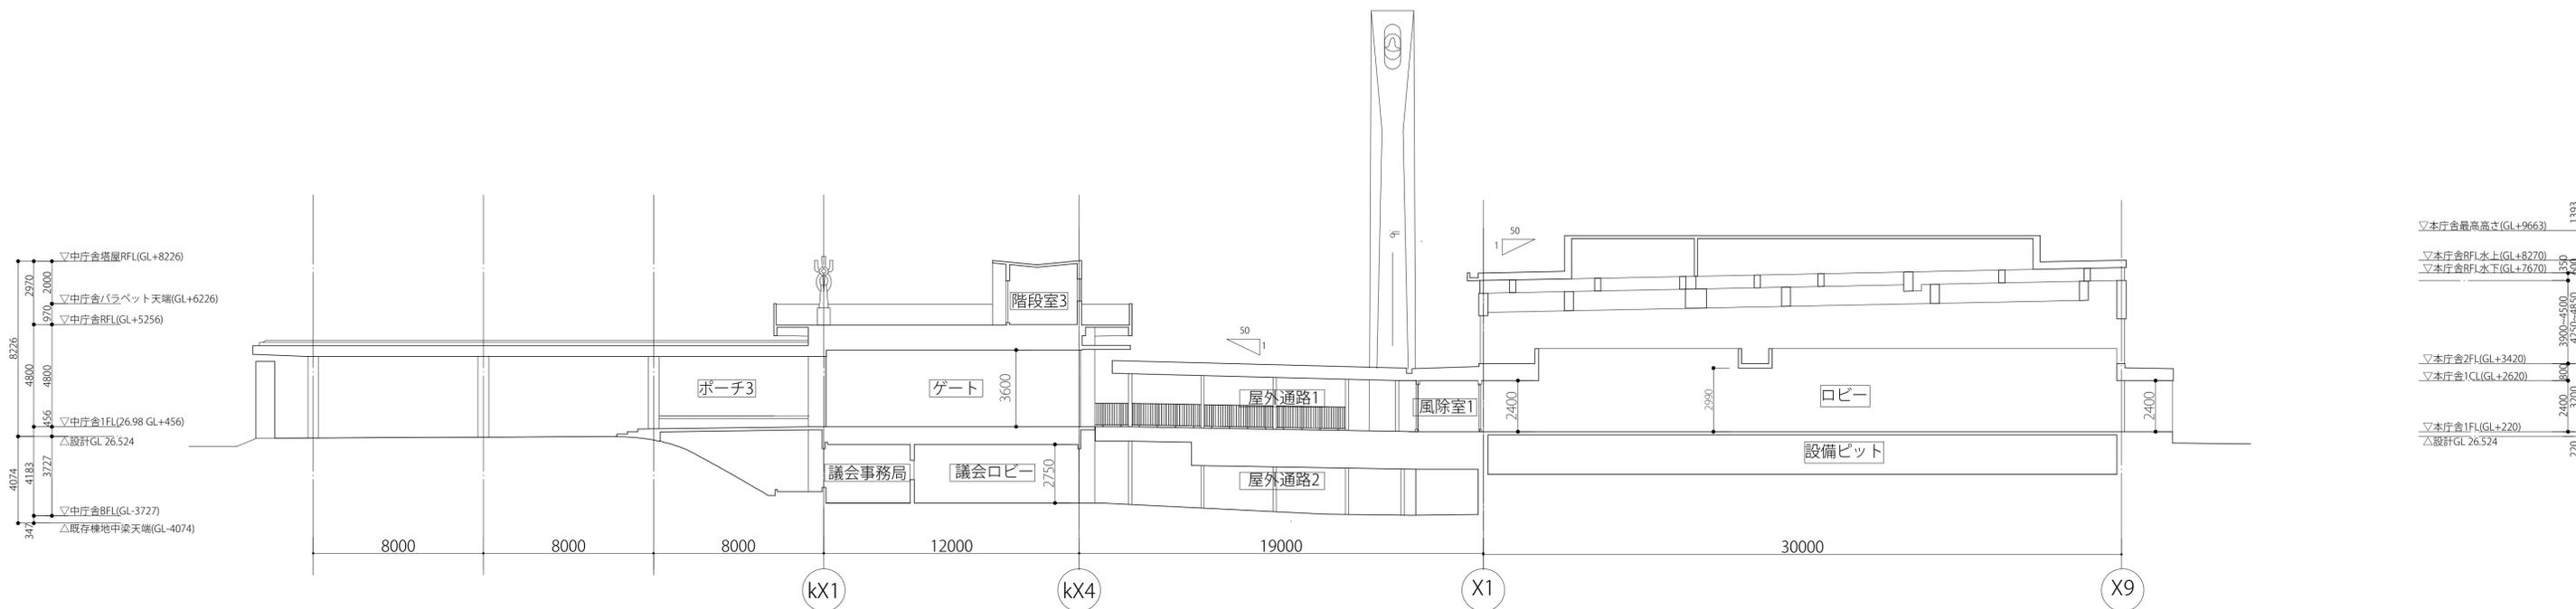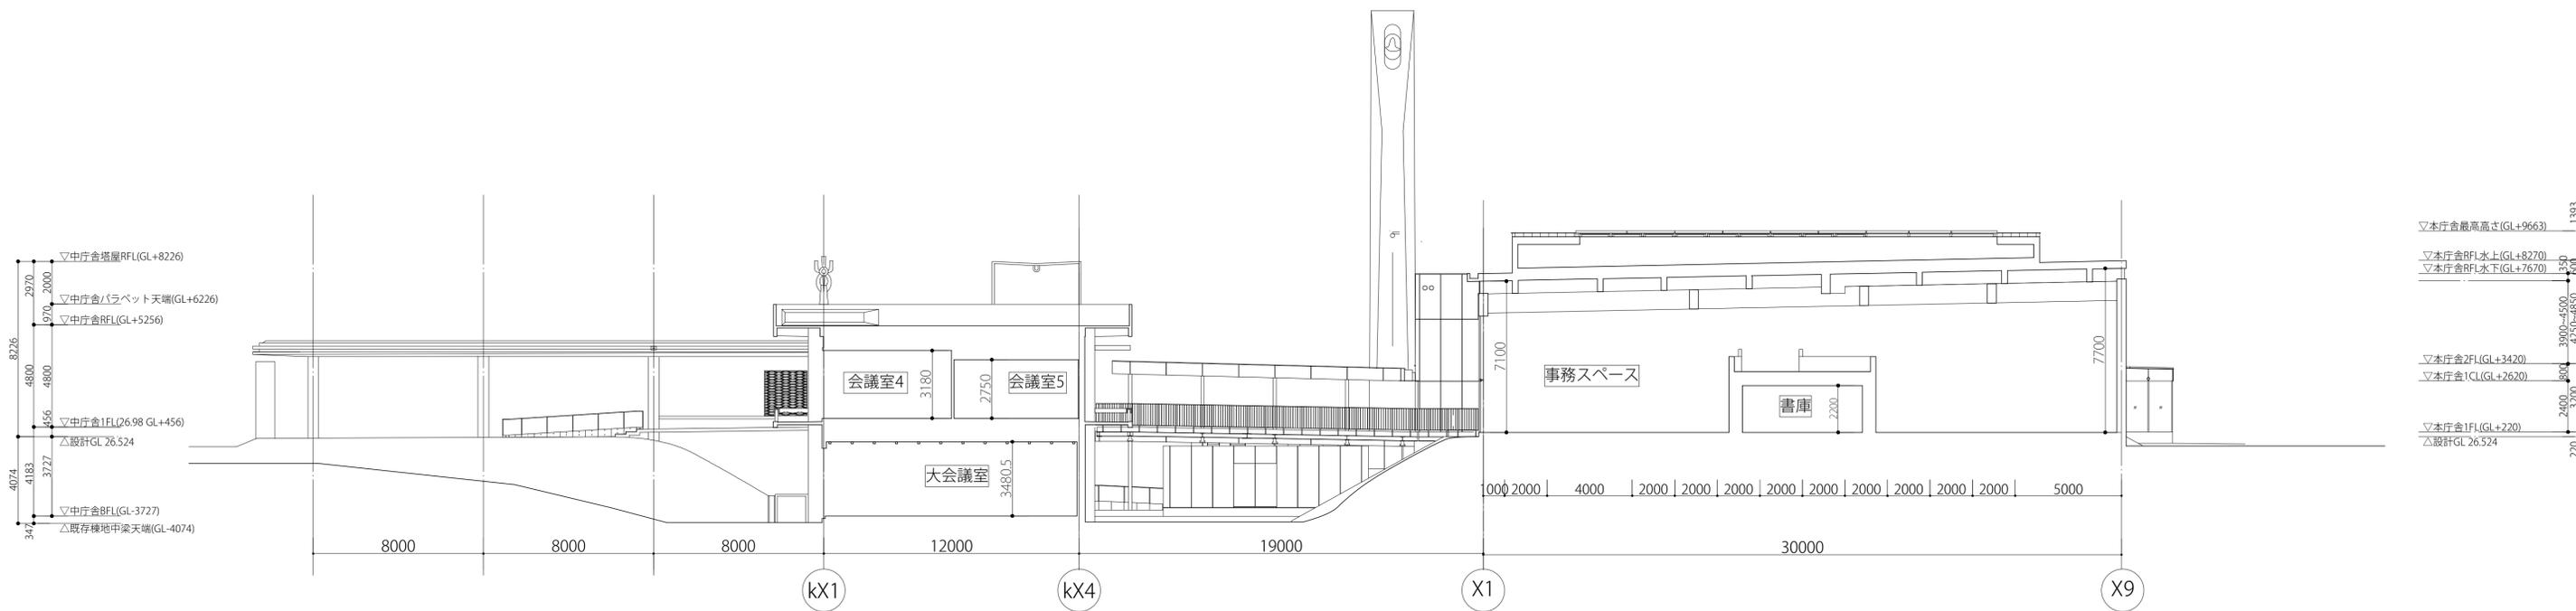


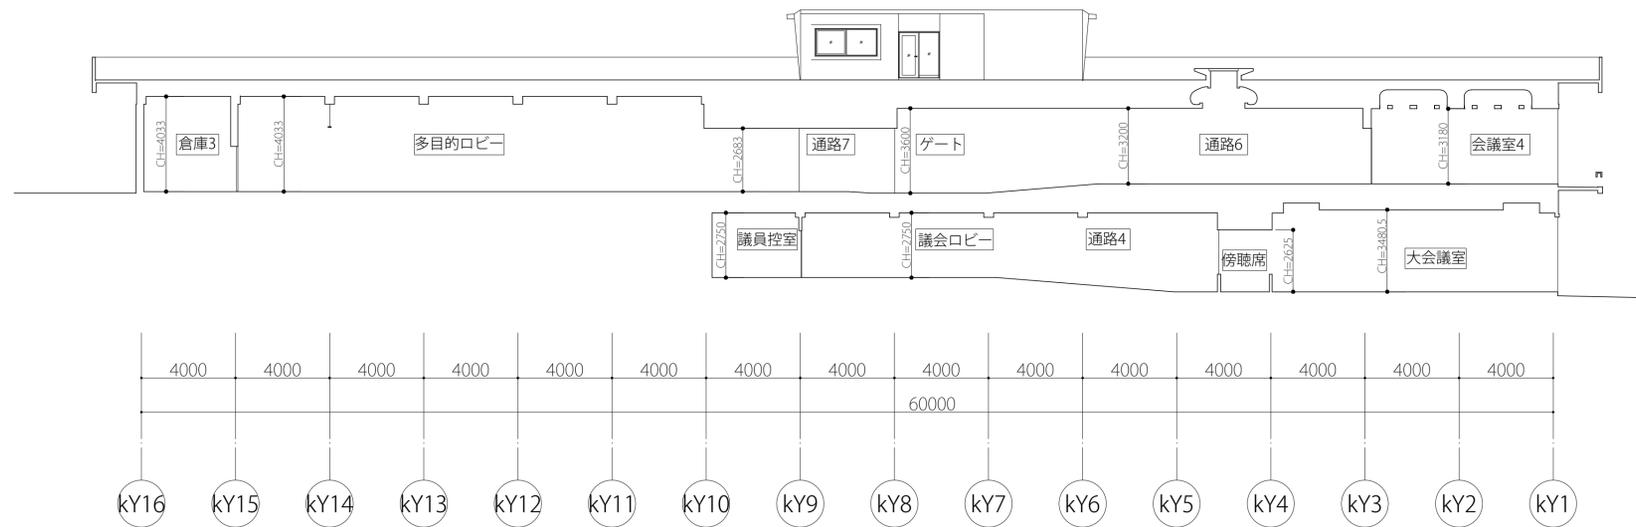
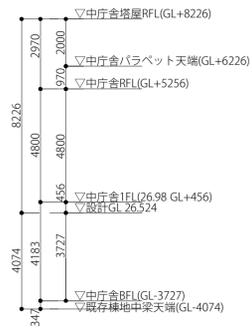
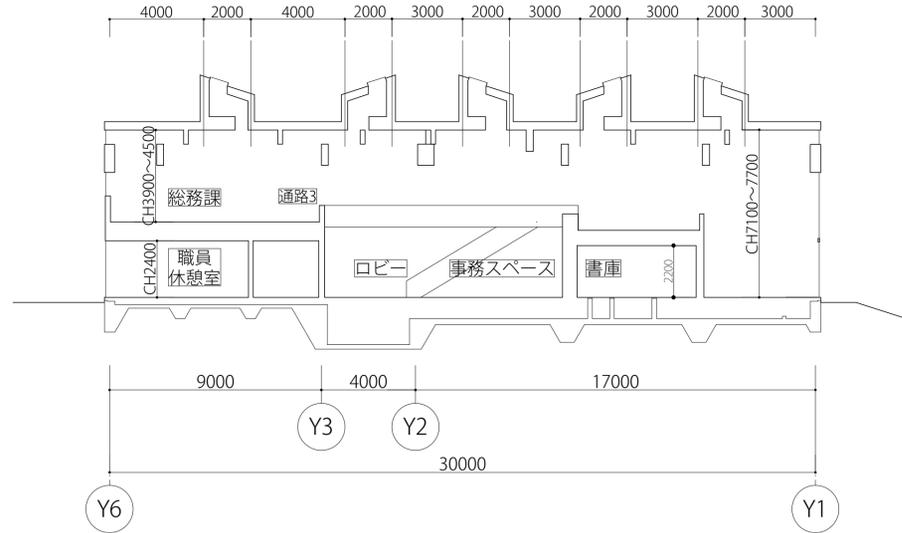
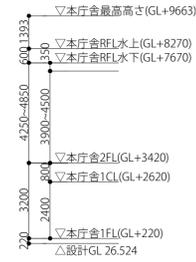


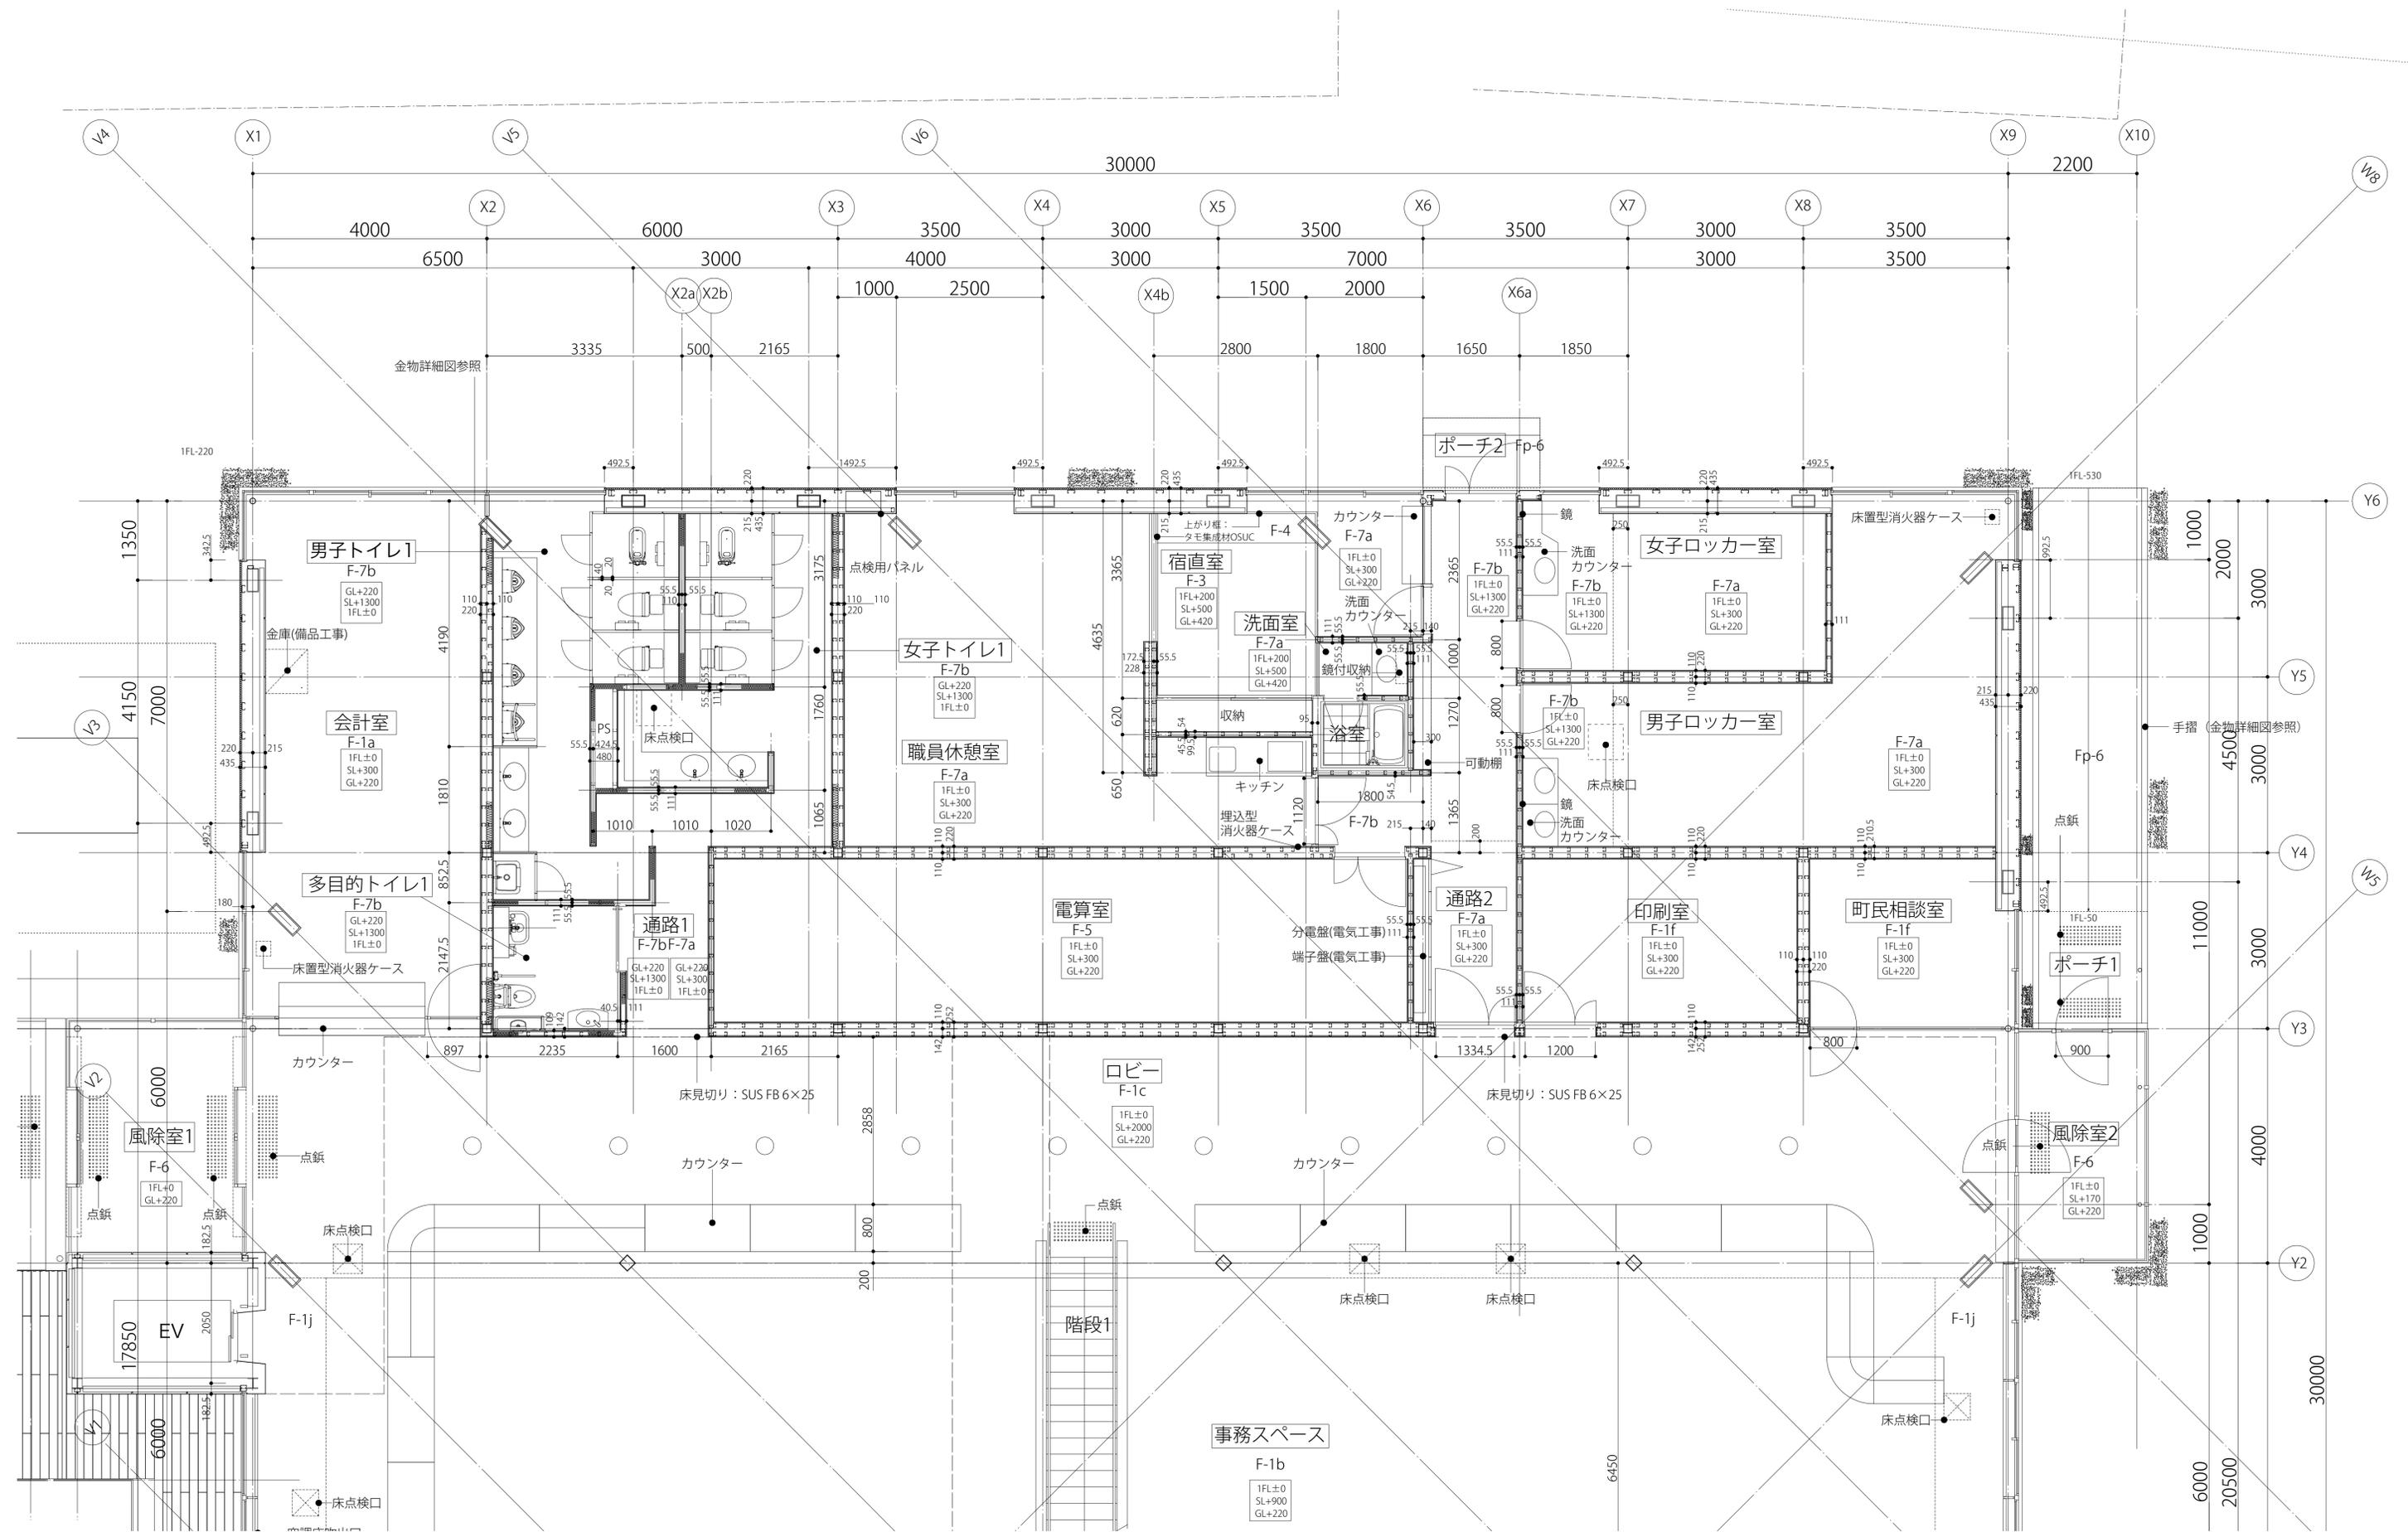


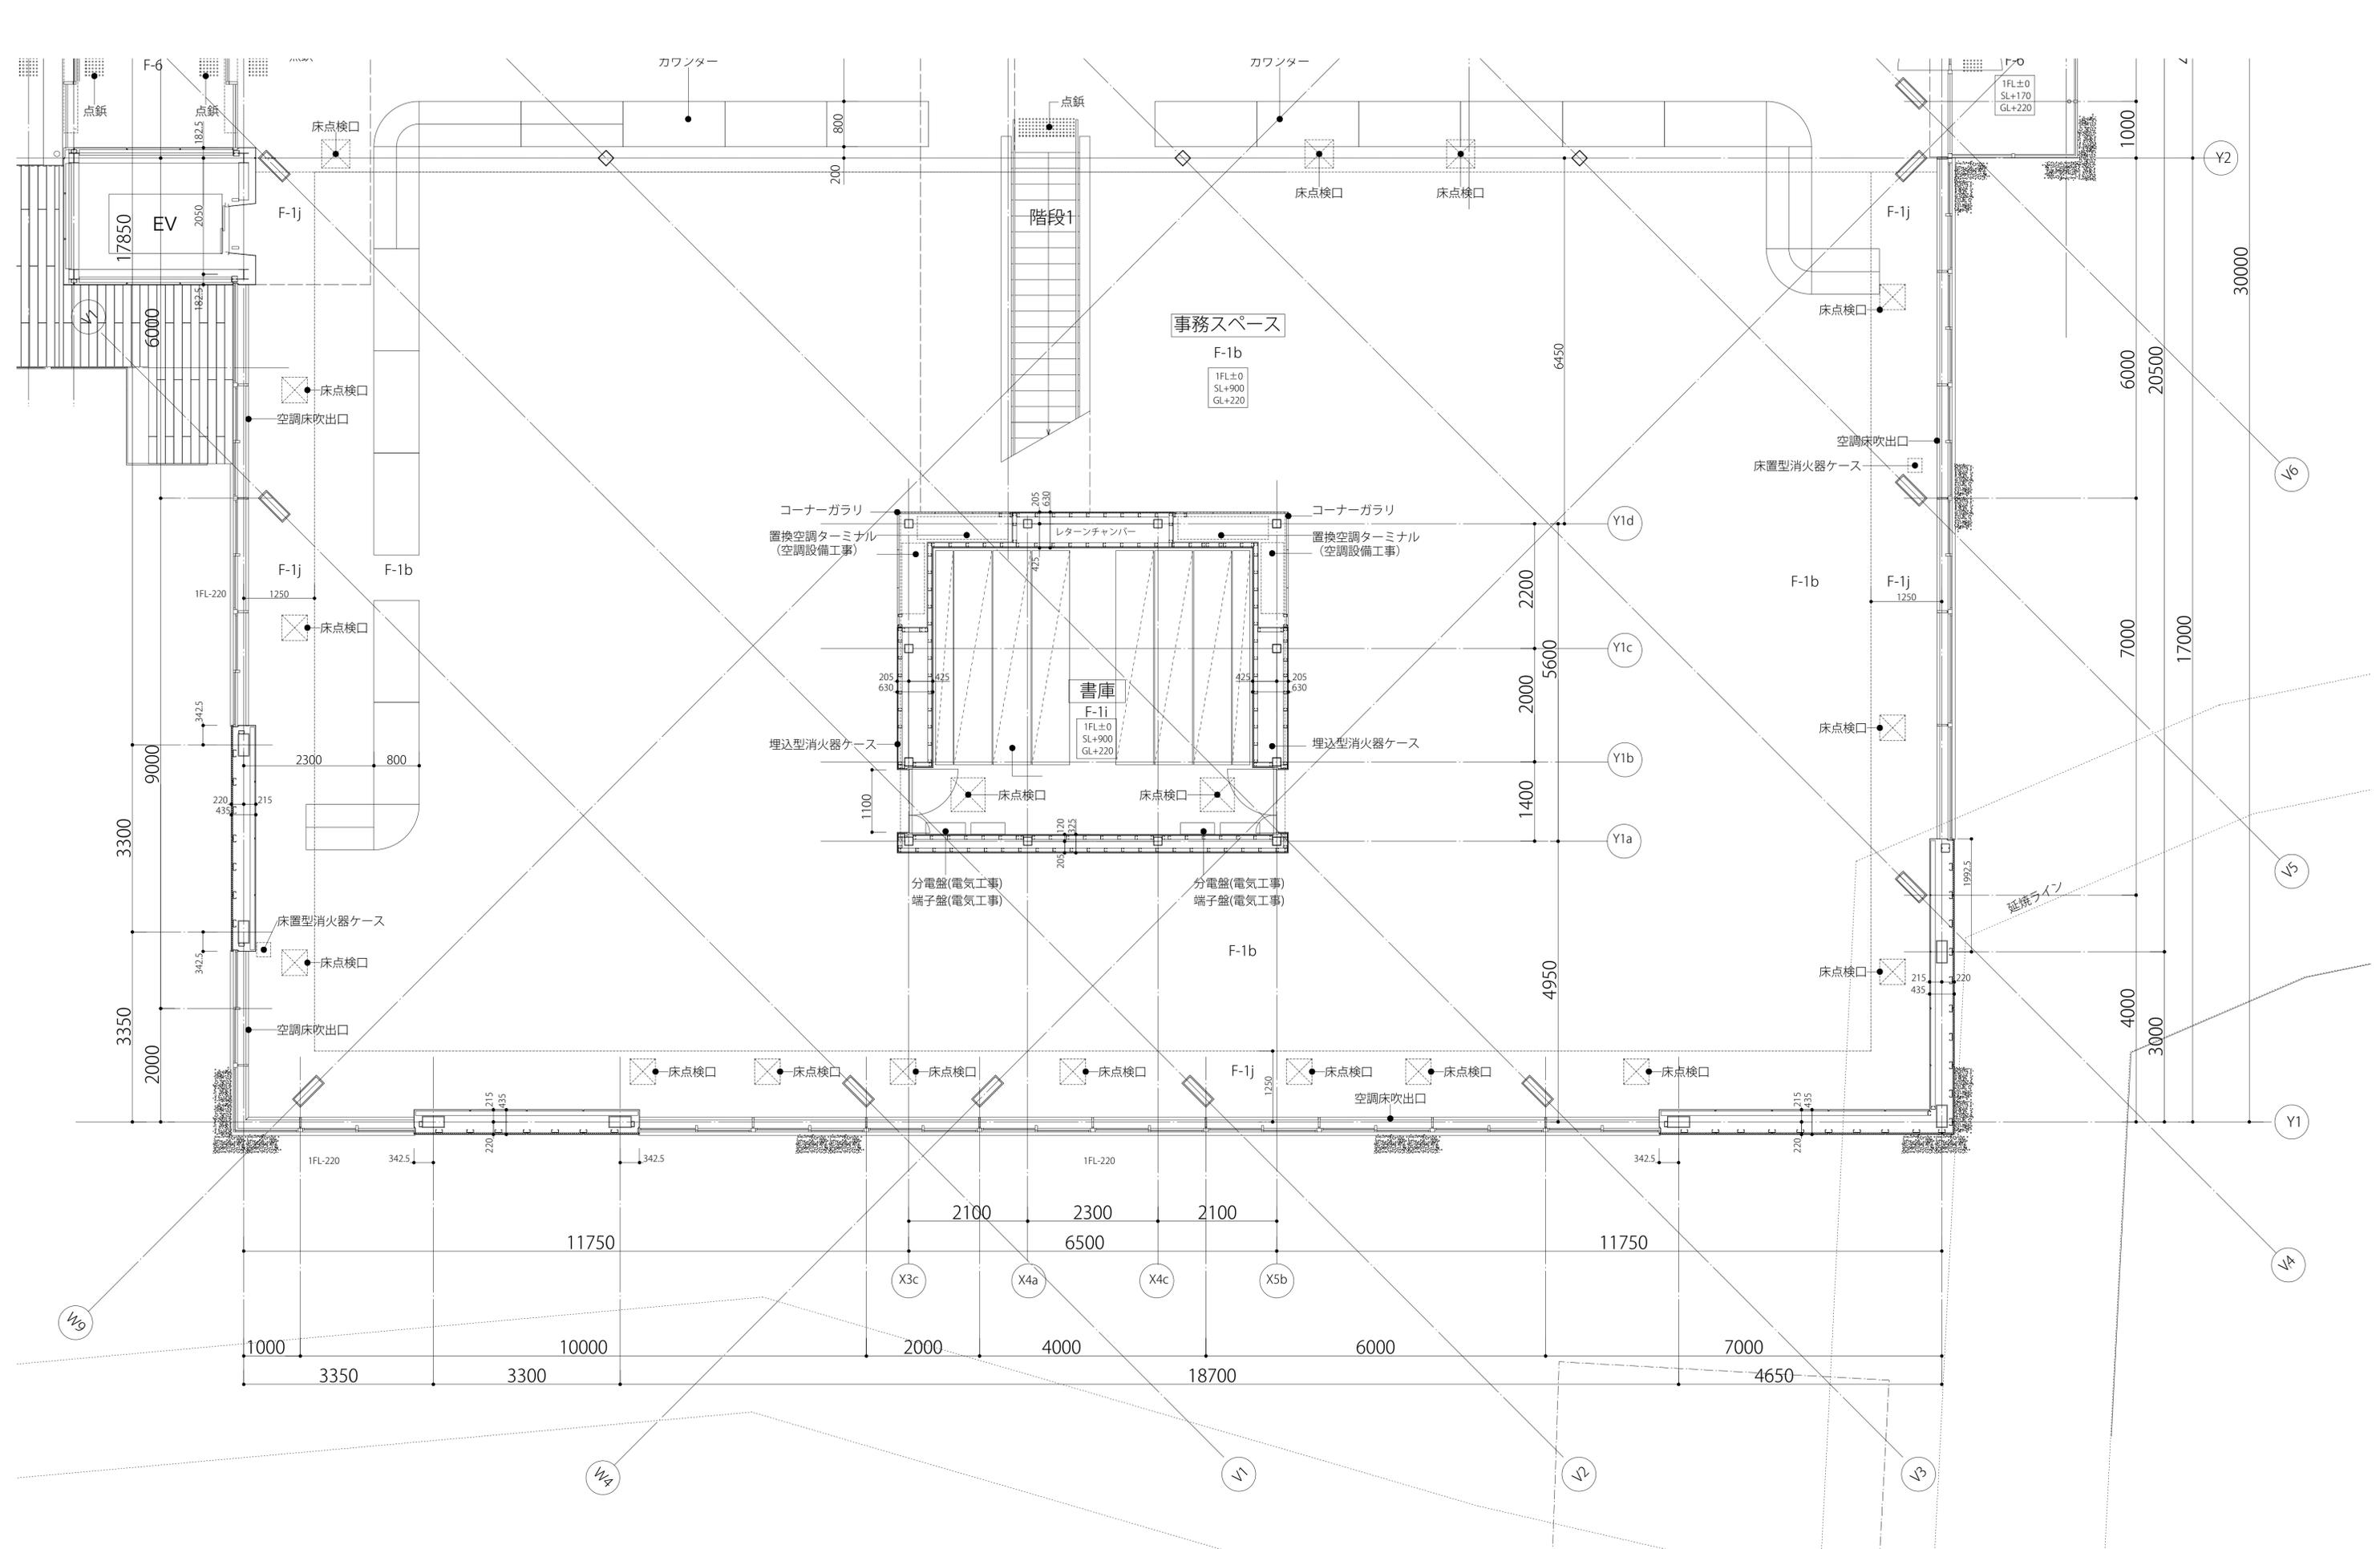


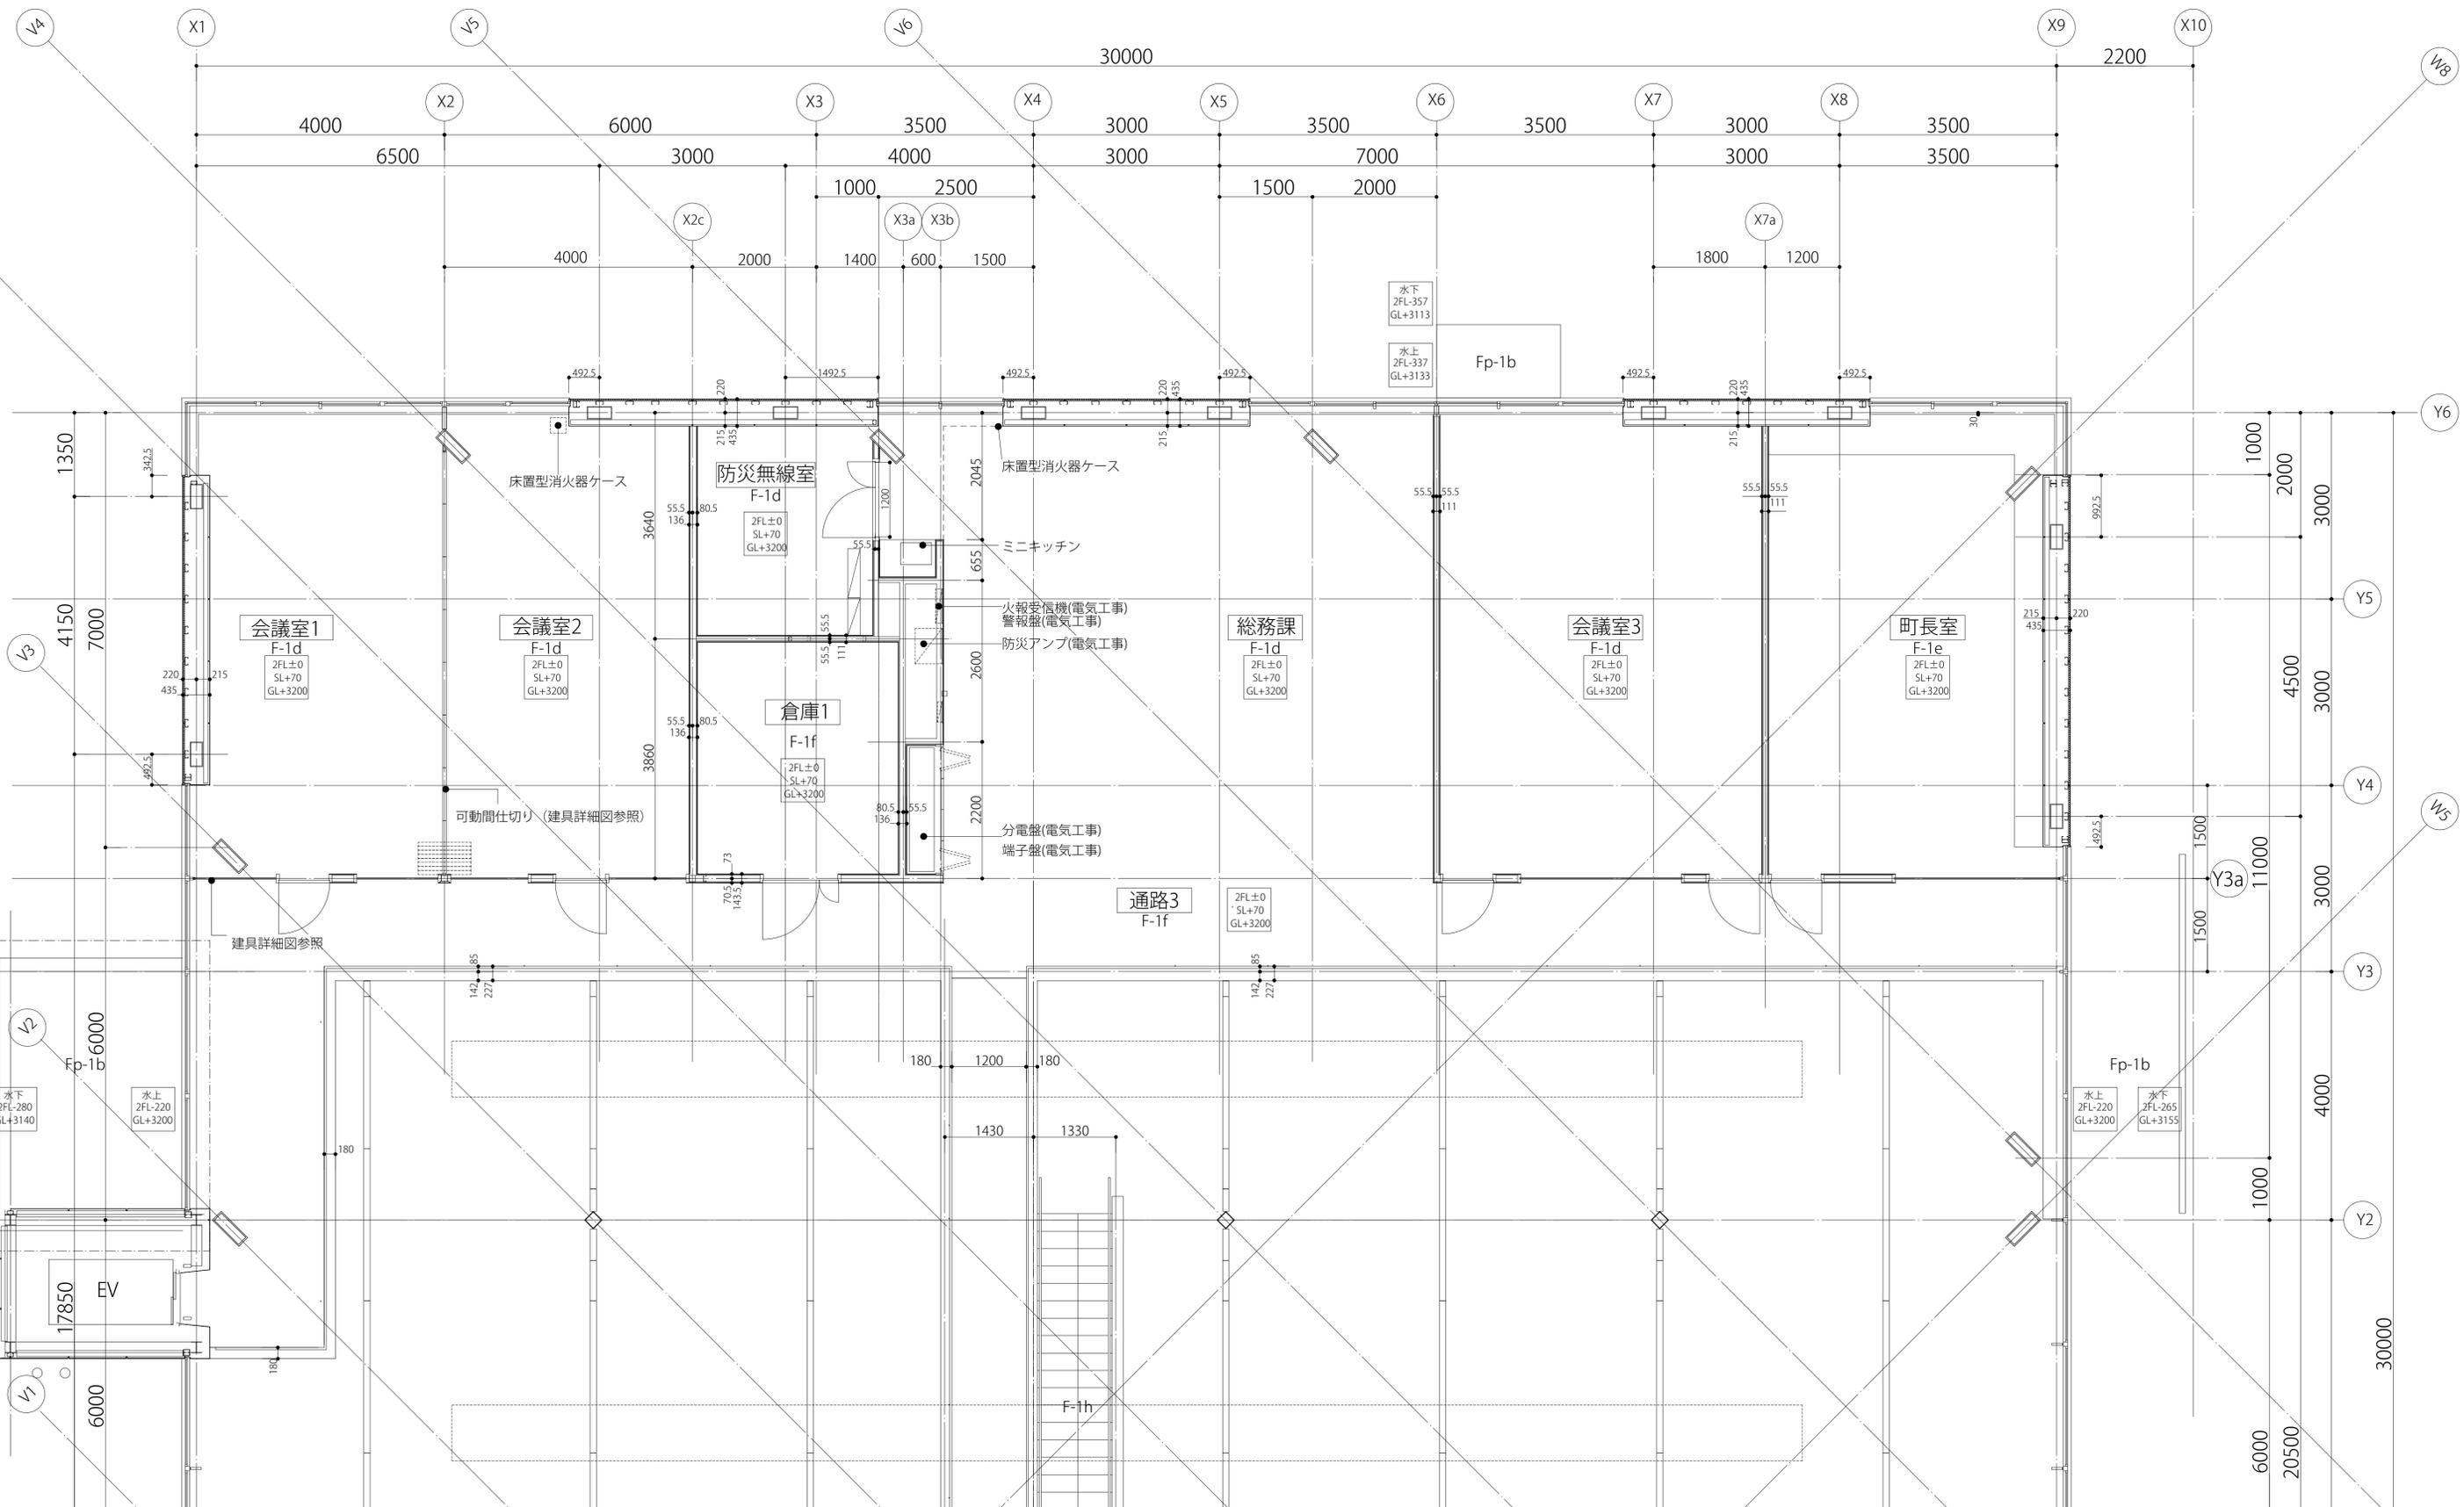


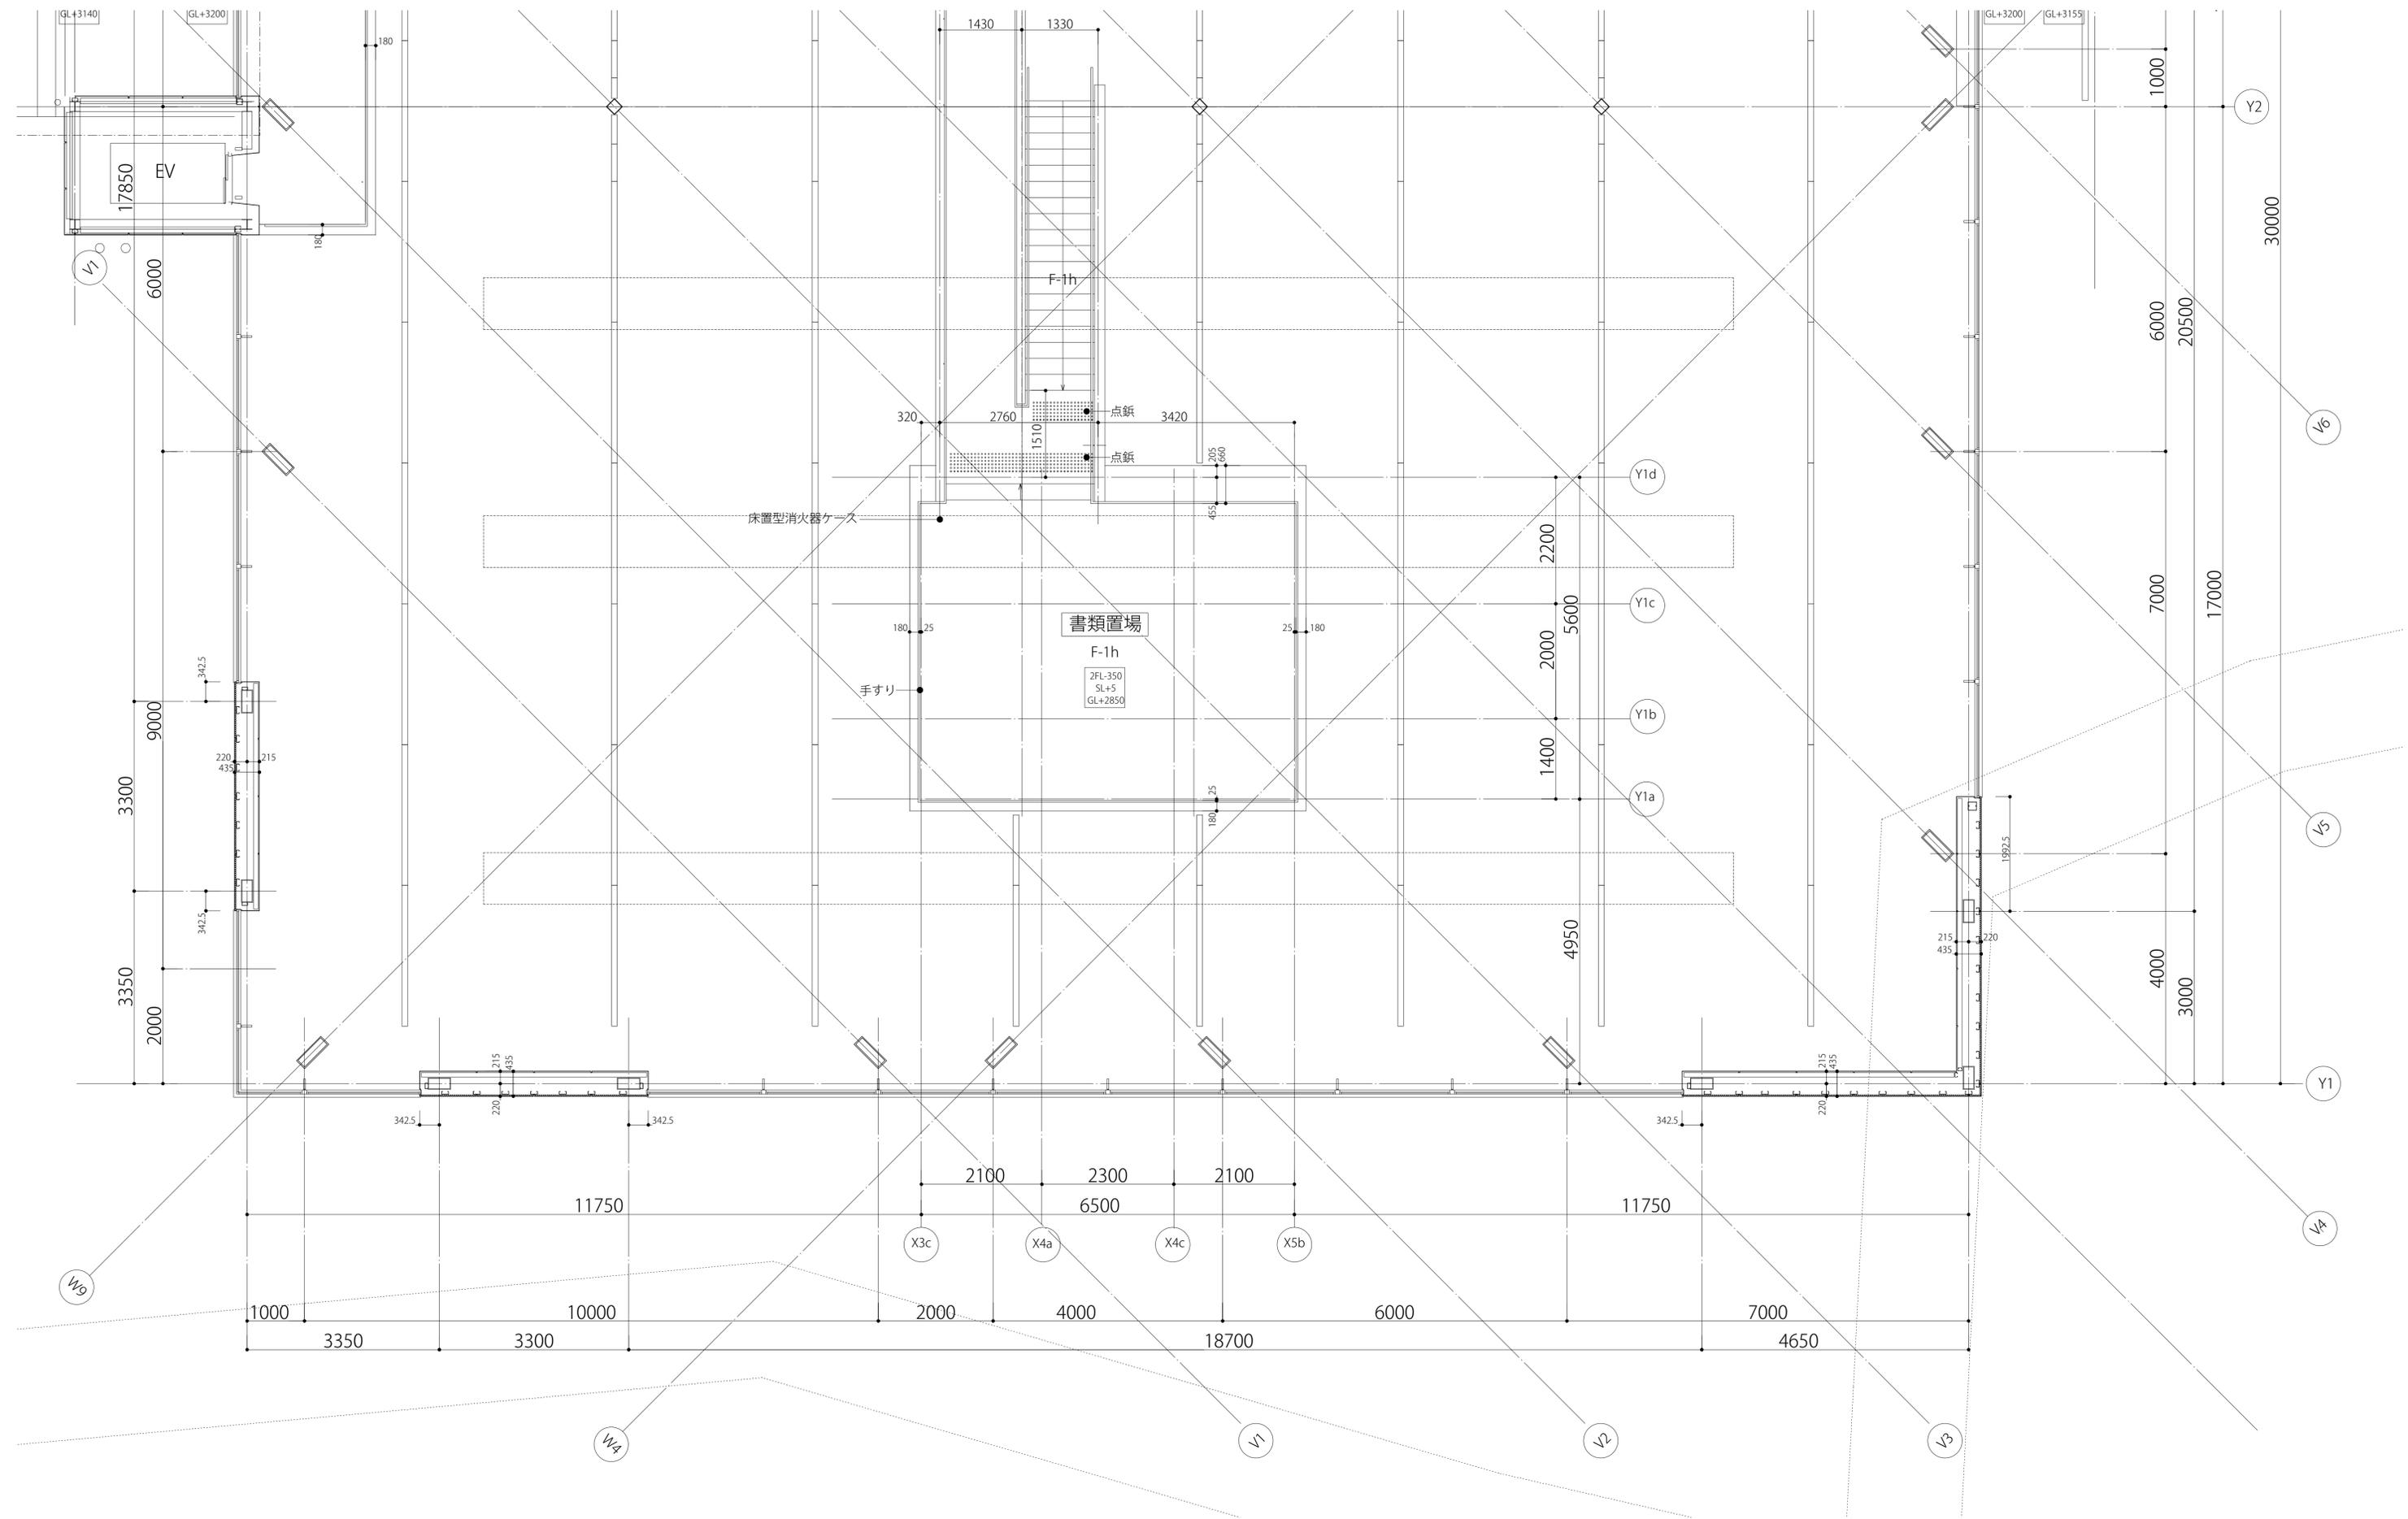


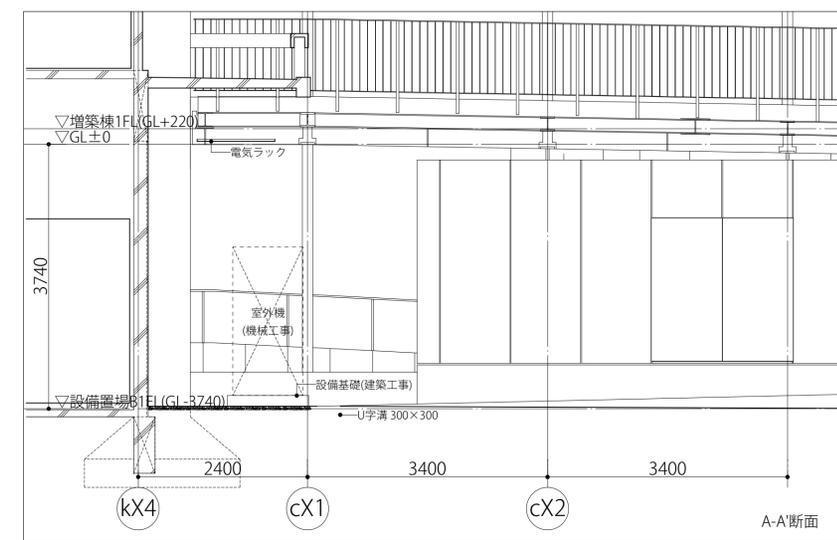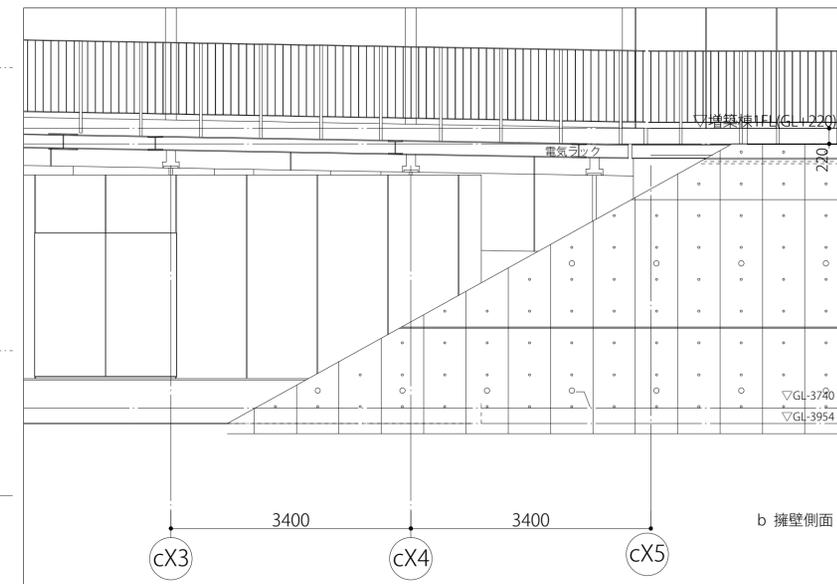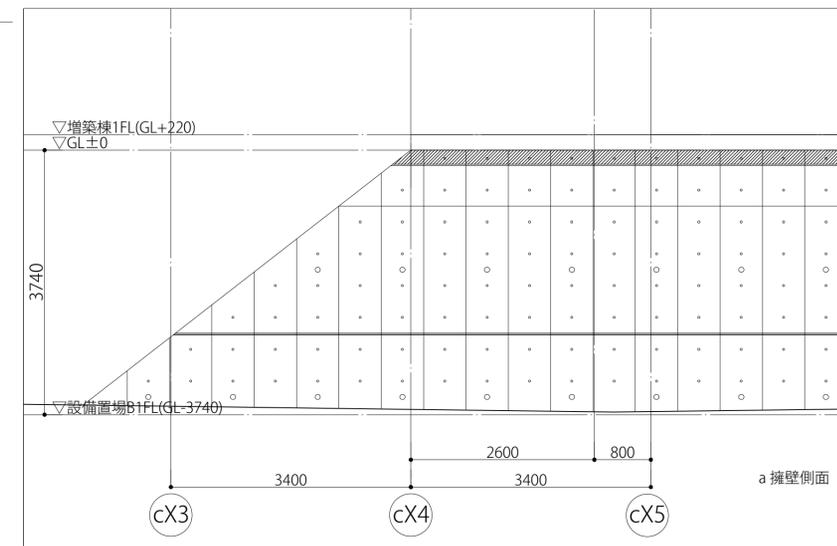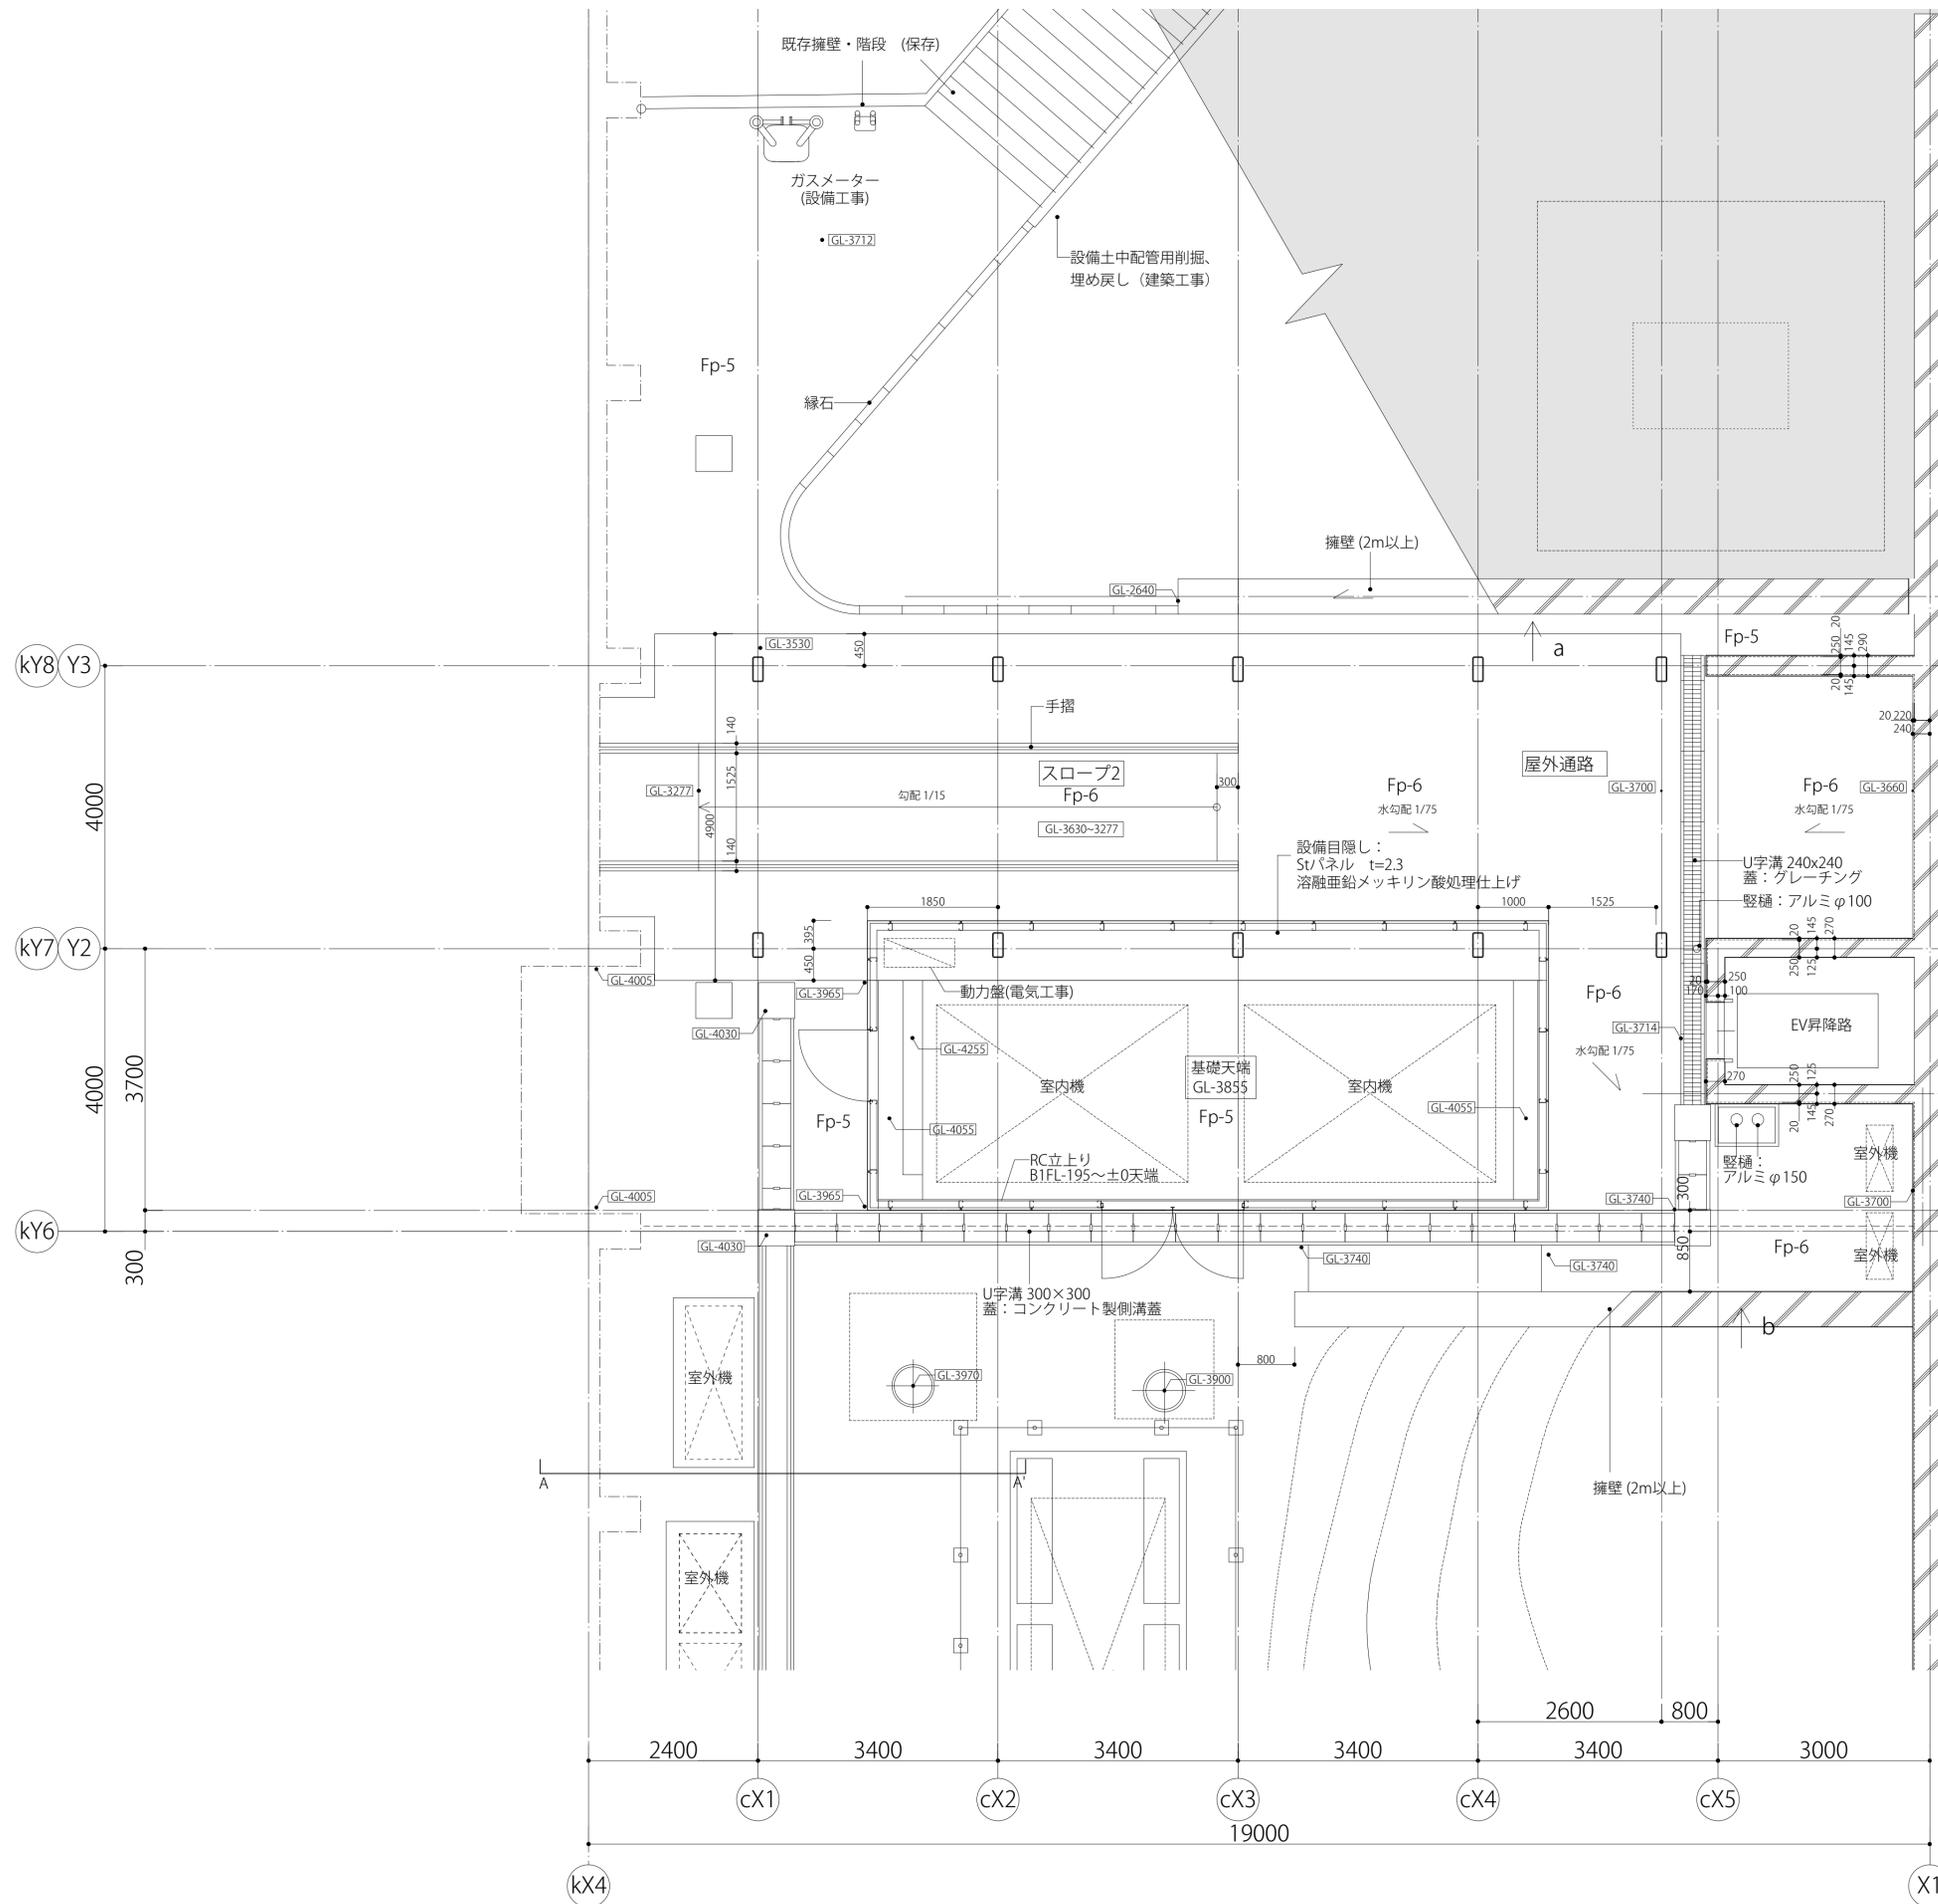


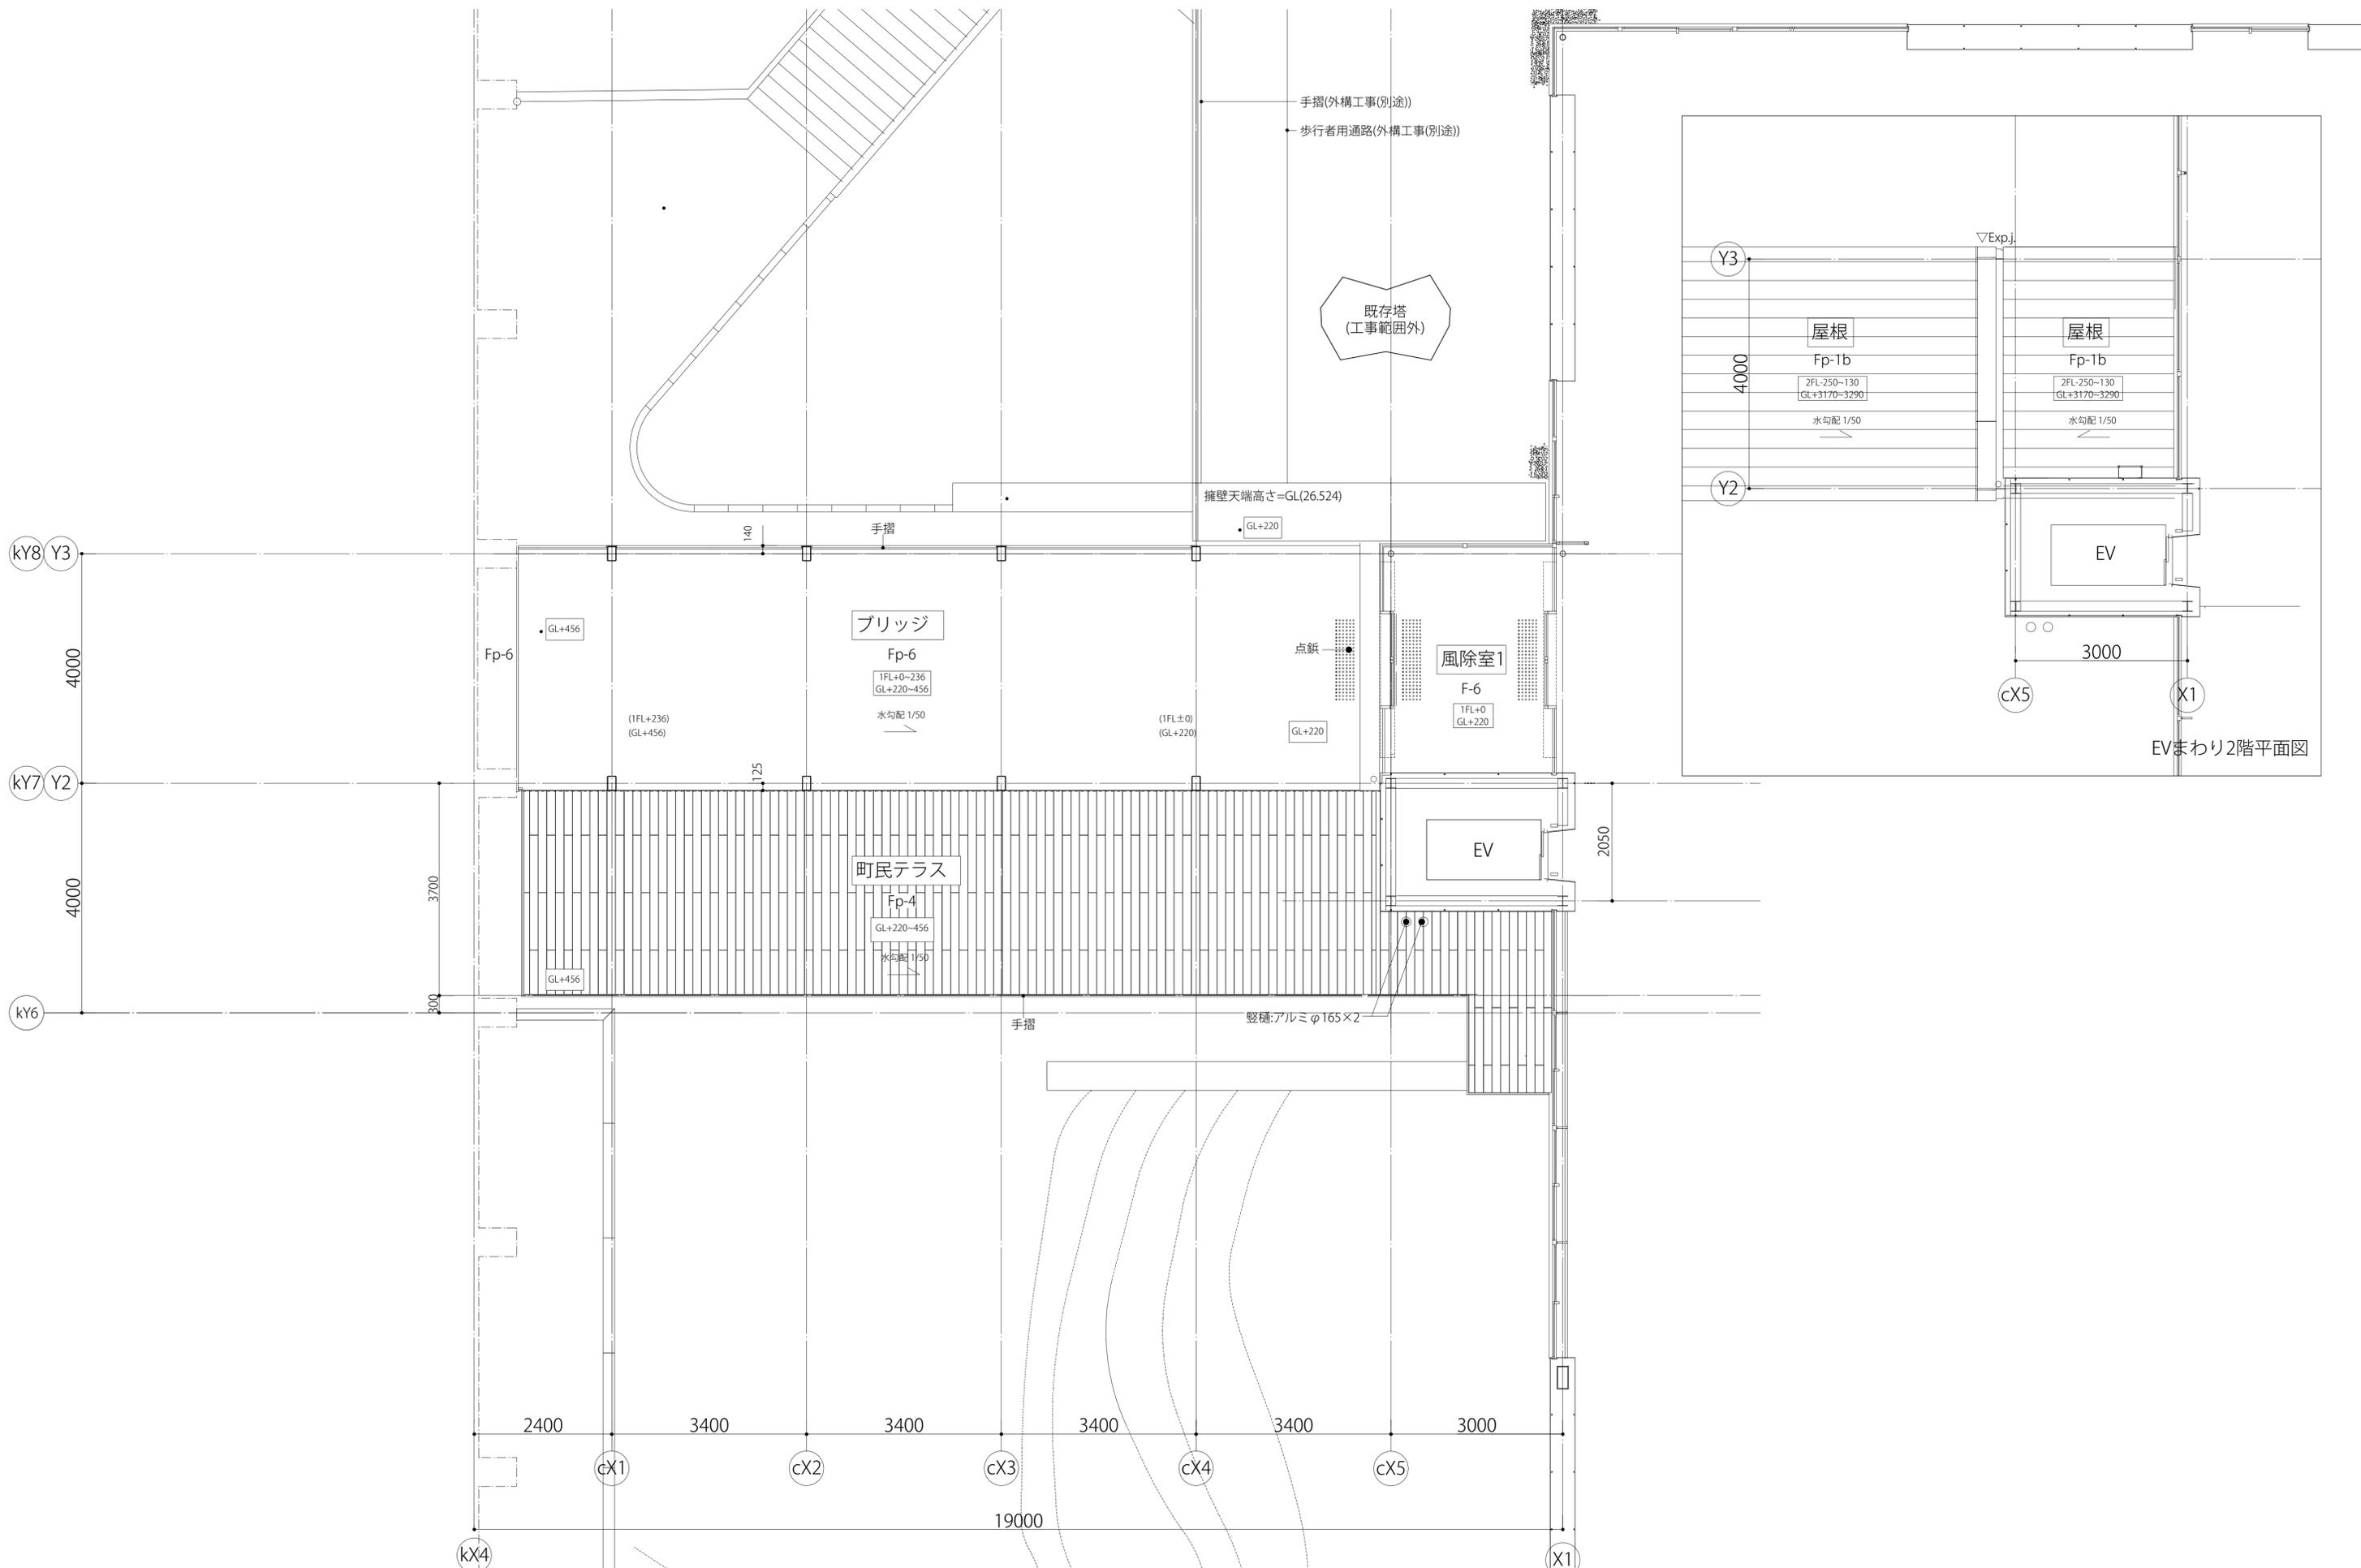

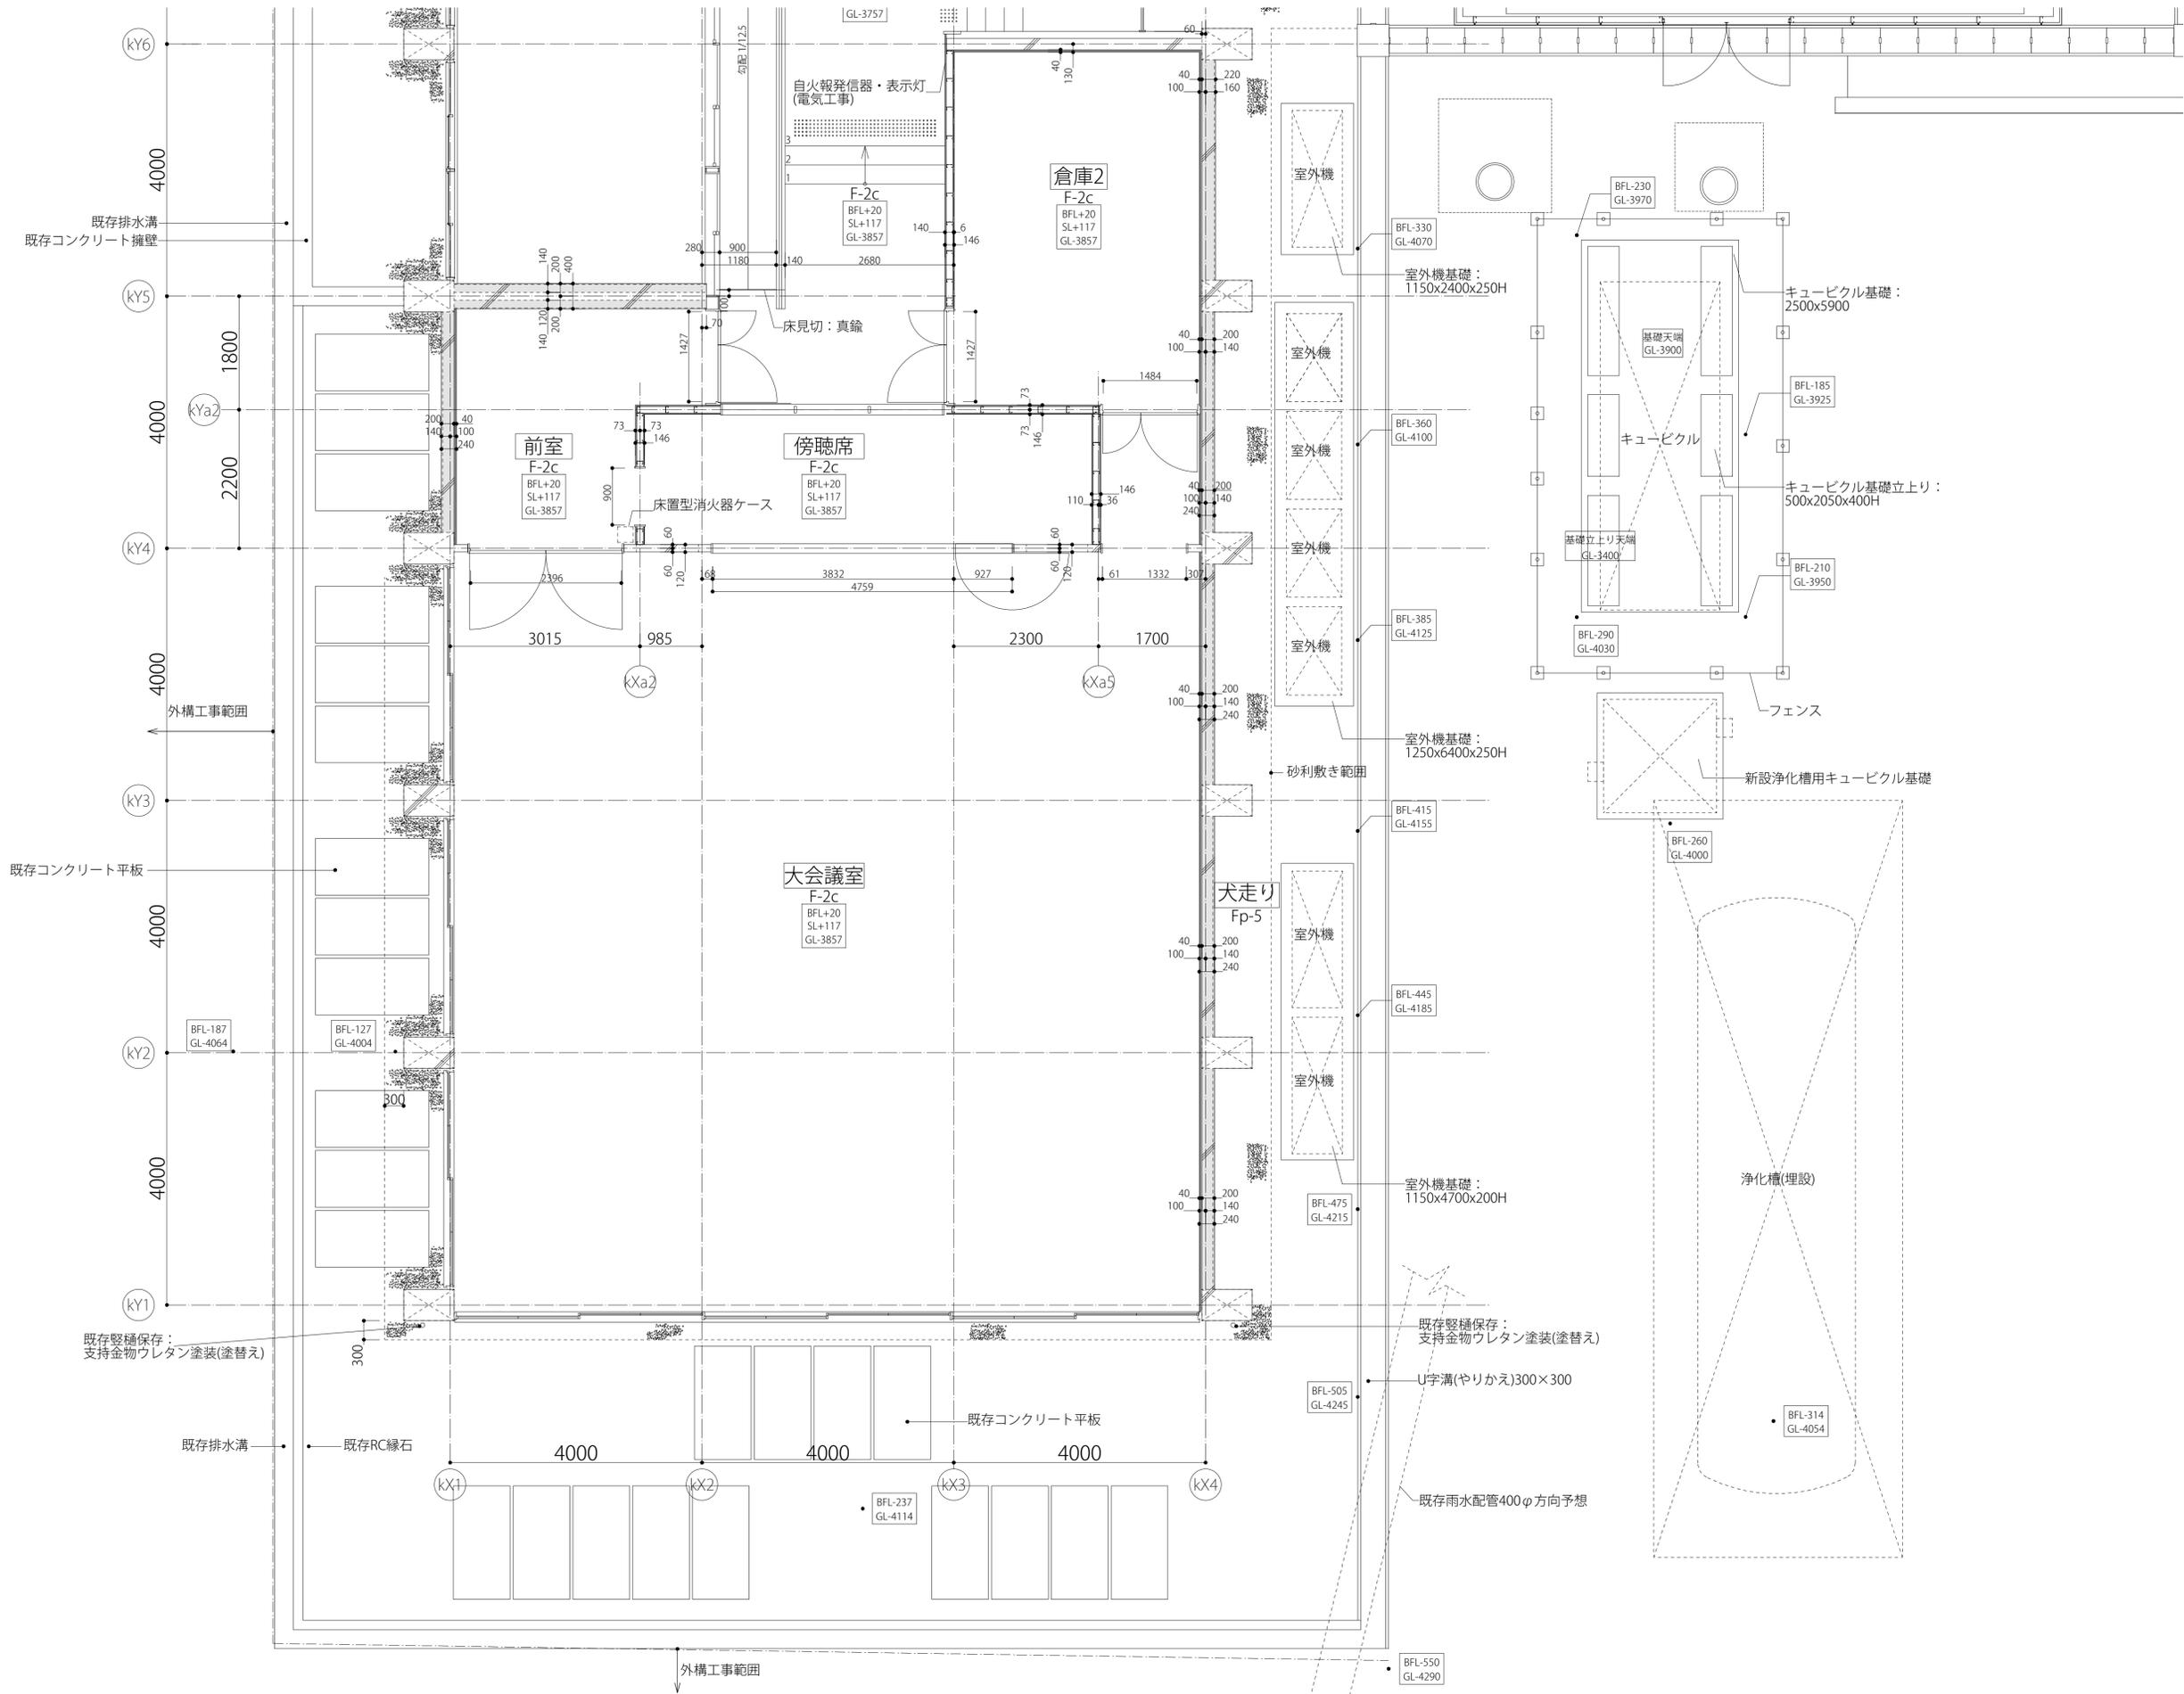

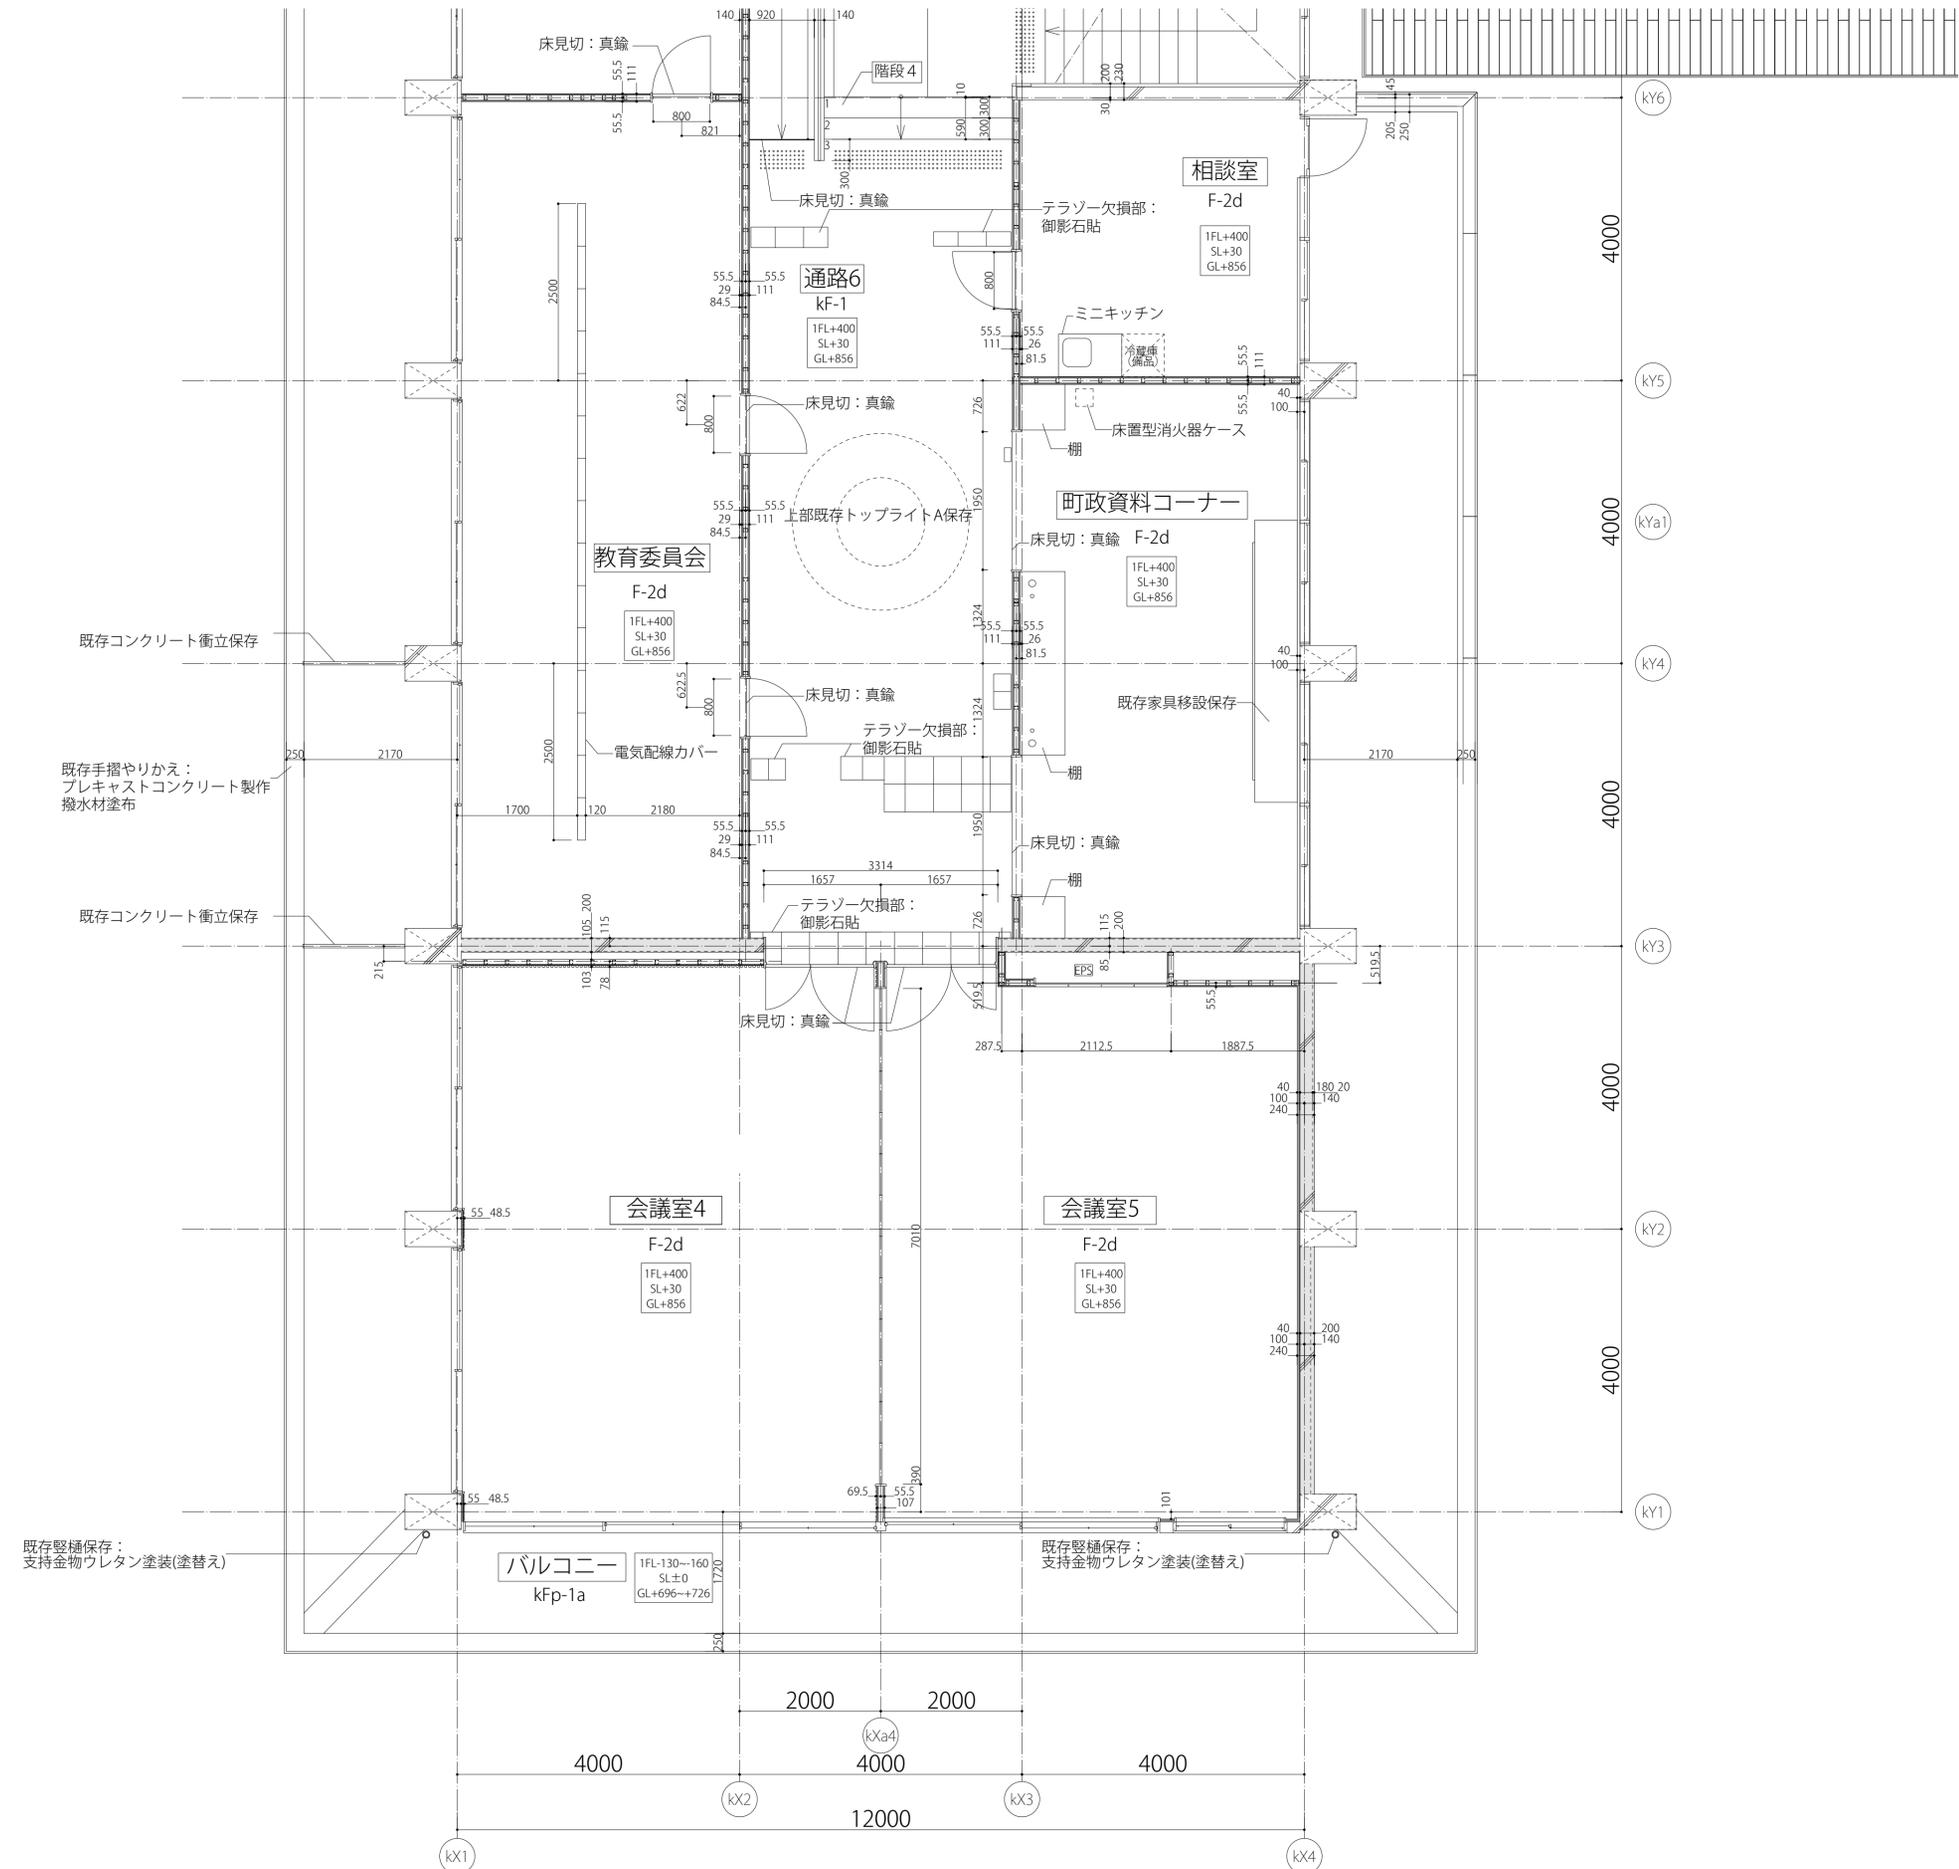


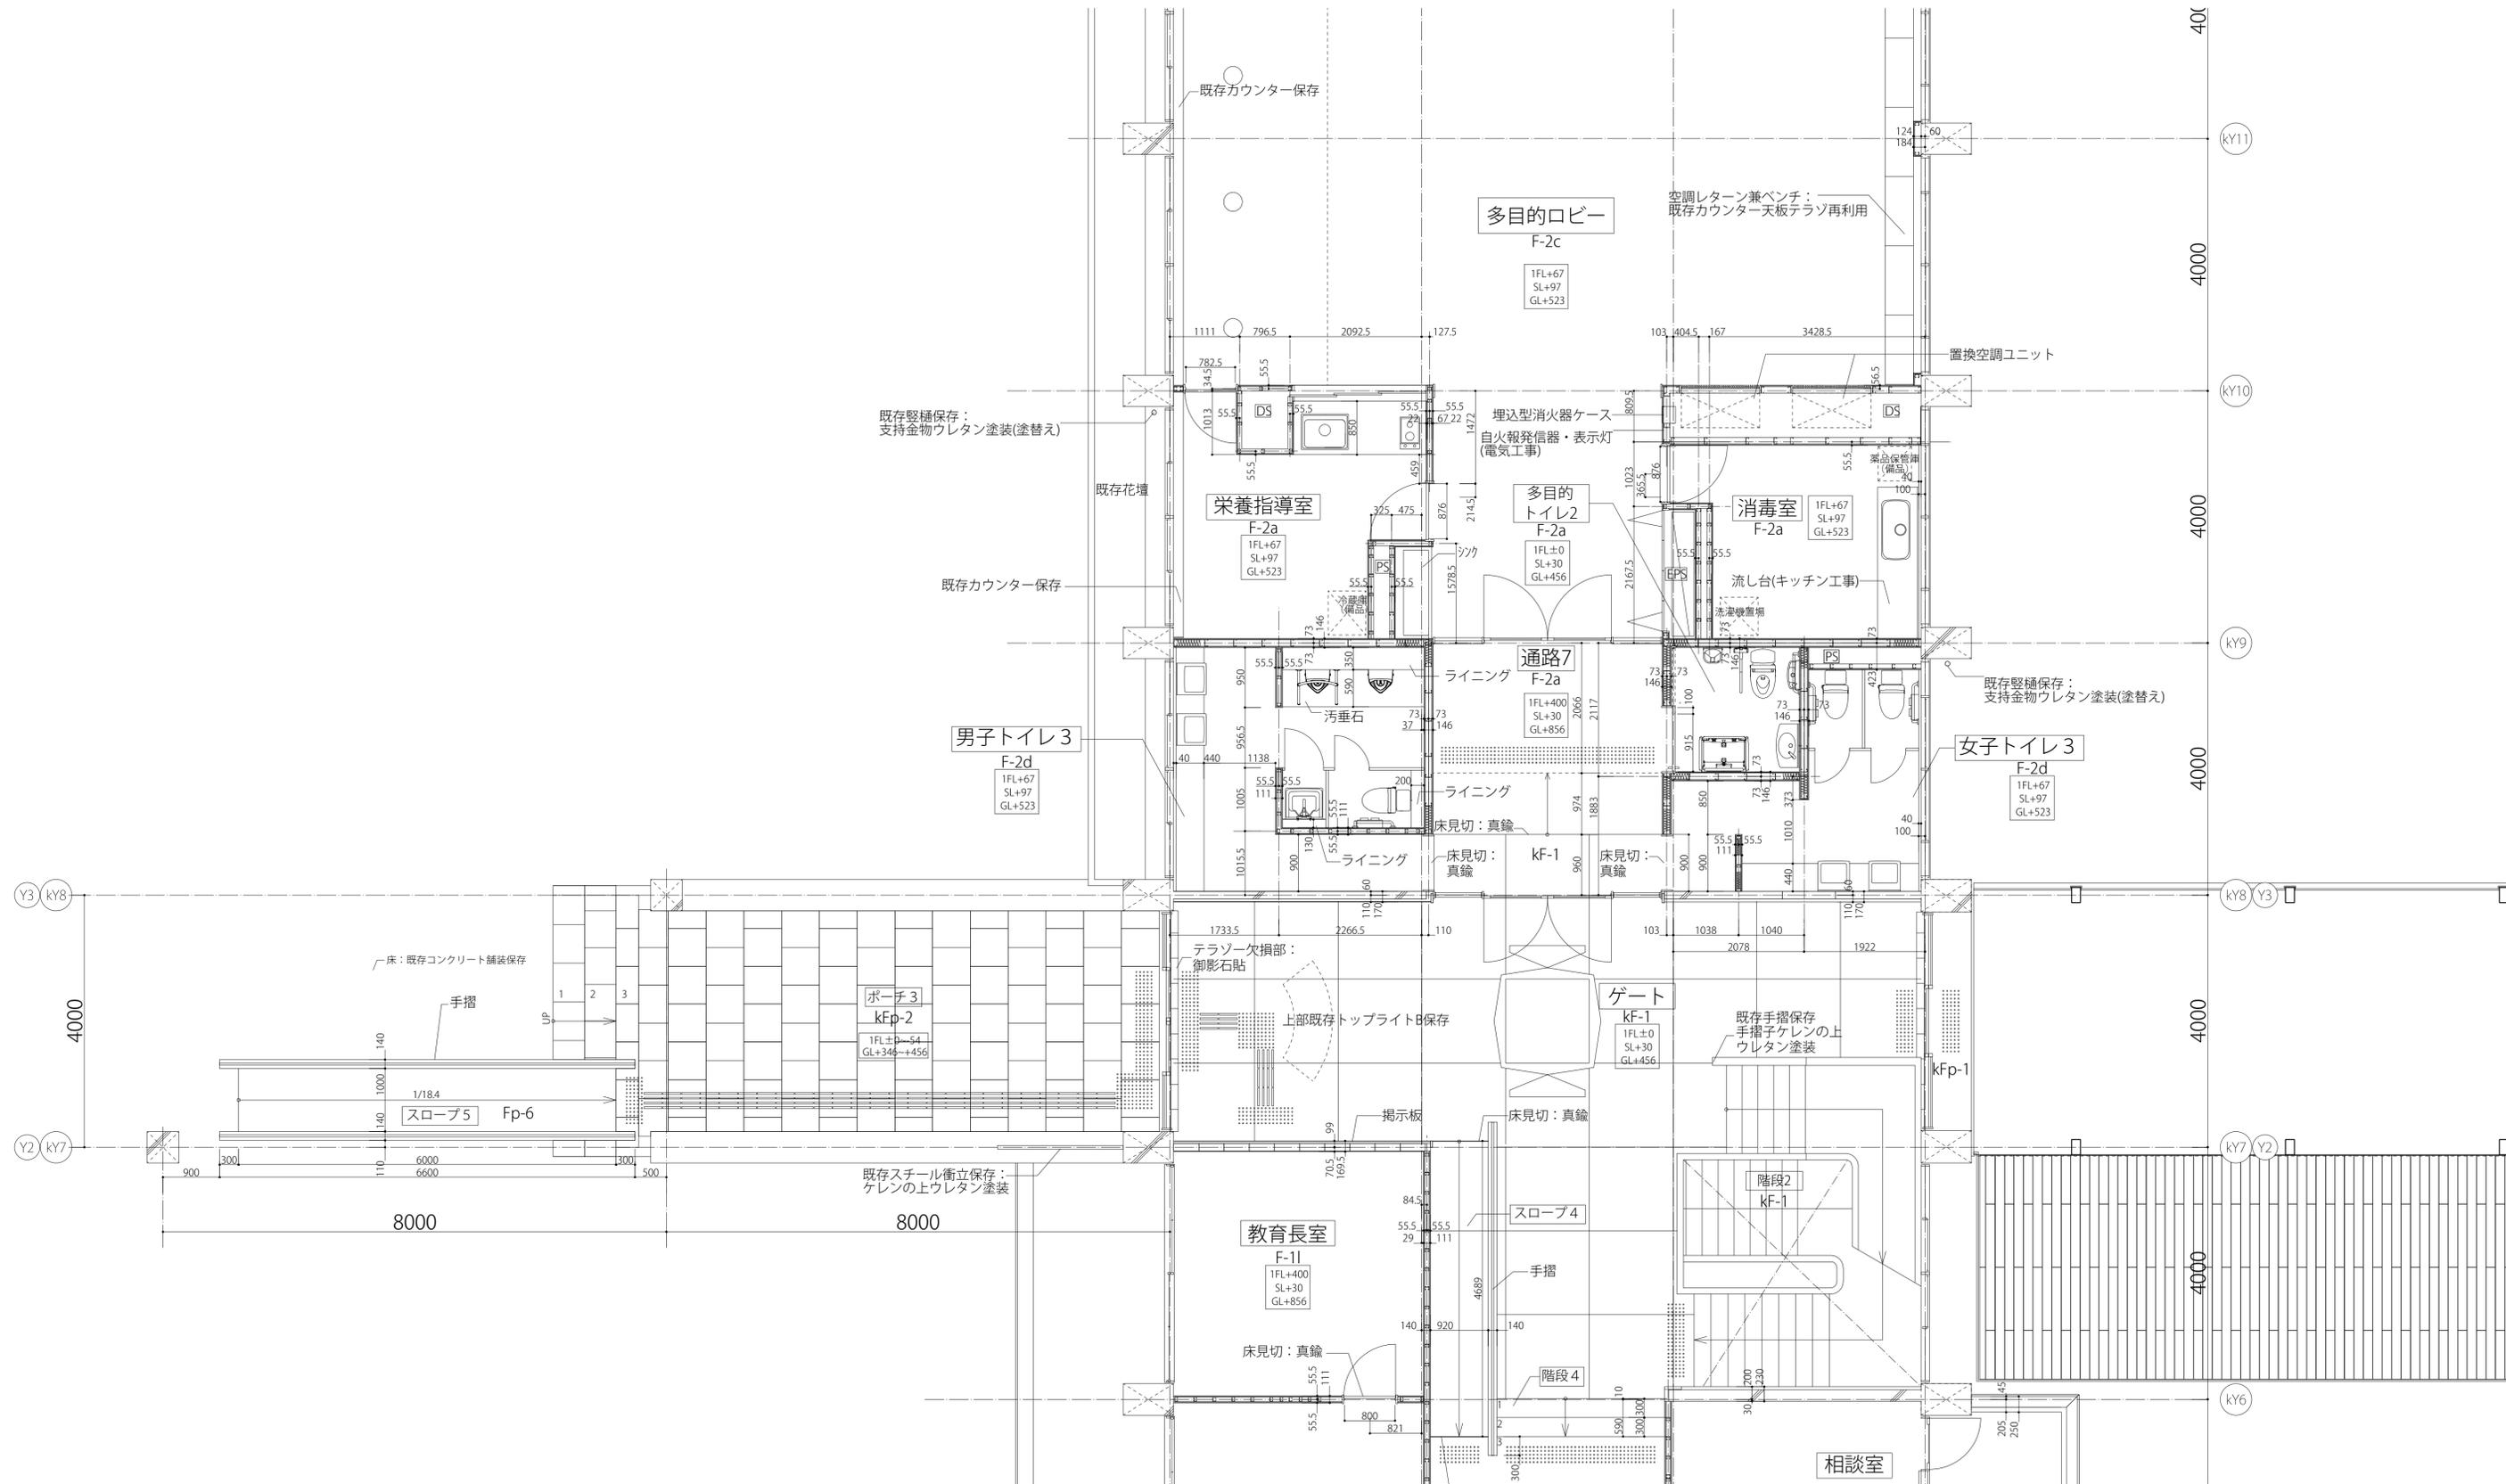

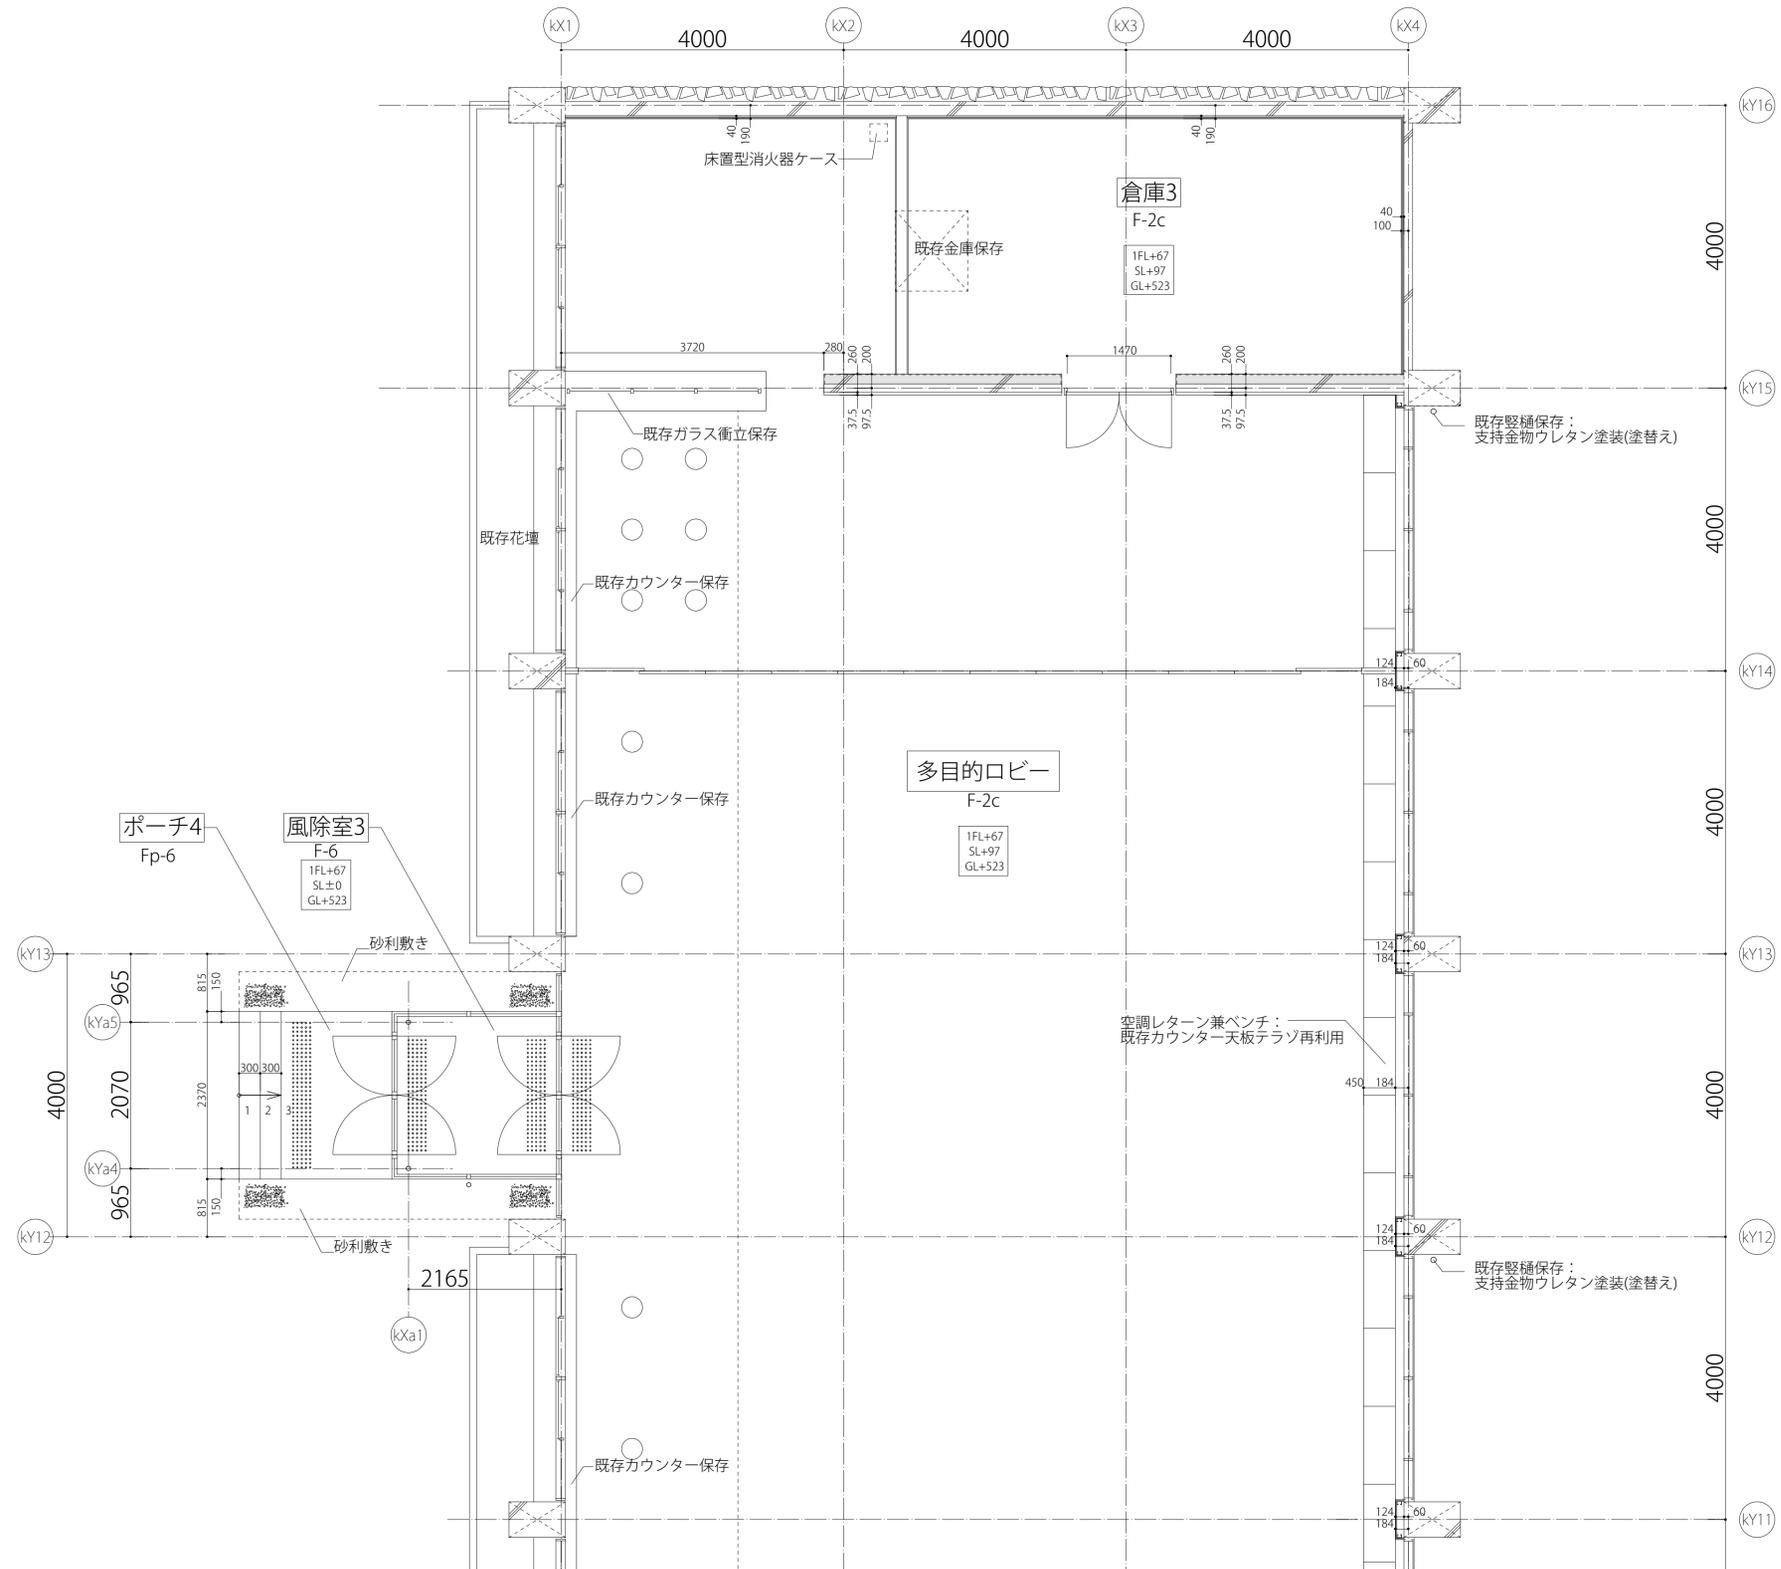

第三庁舎1階平面図

S=1:100 (A4)

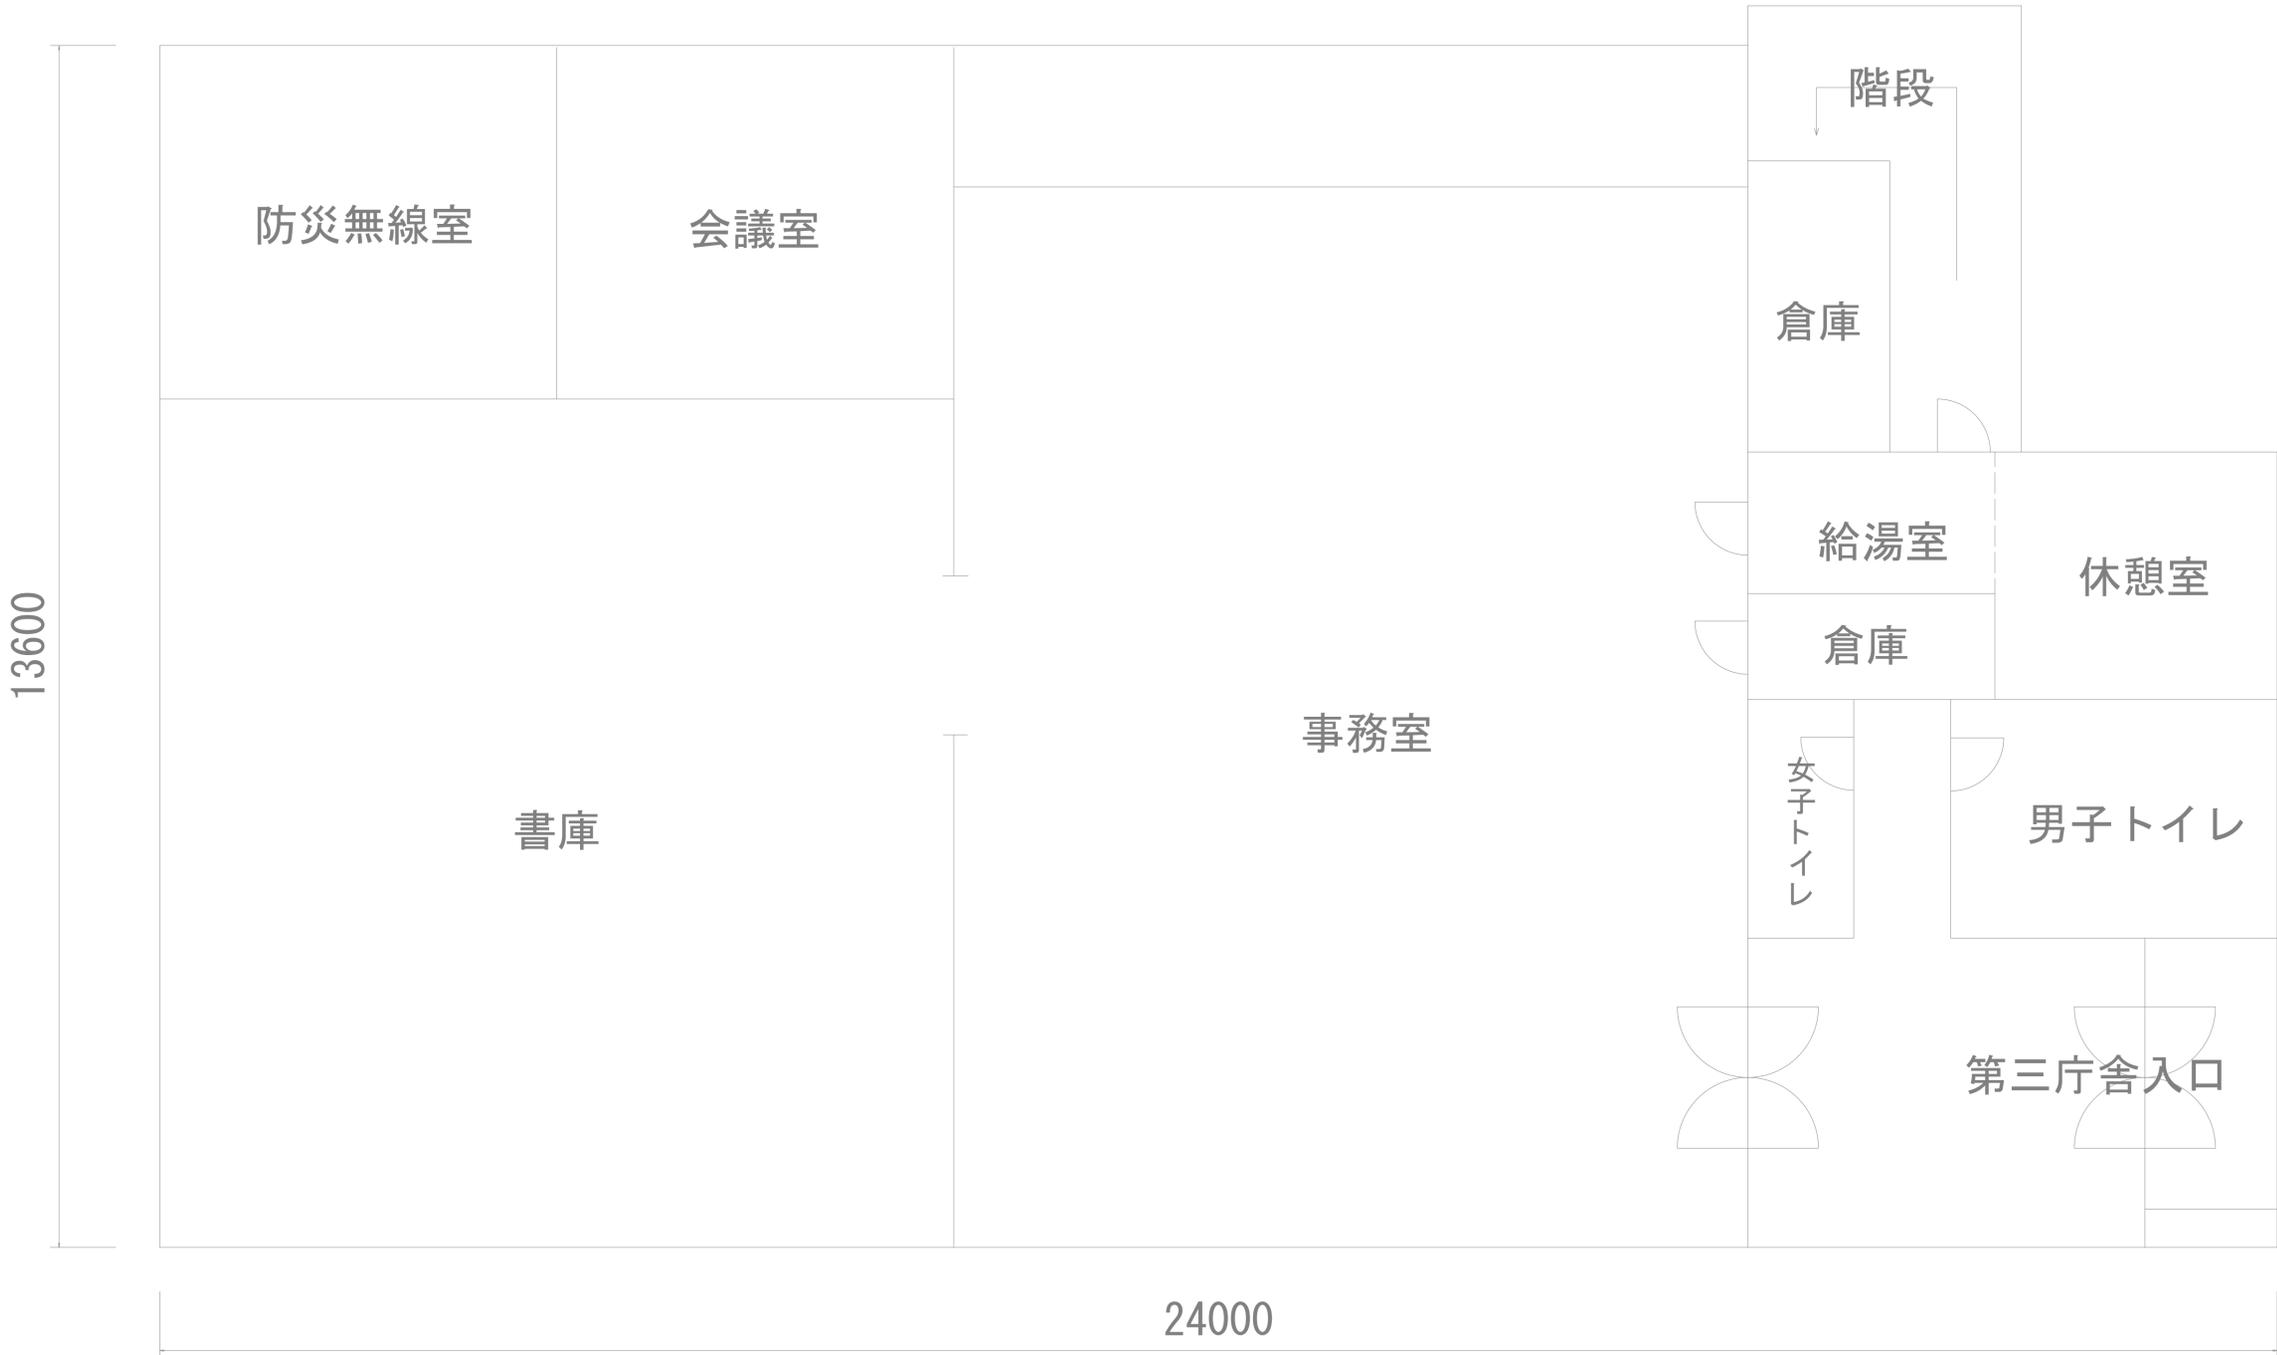

第三庁舎2階平面図

S=1:100 (A4)

